


T.29S., R.12 W., W.M.

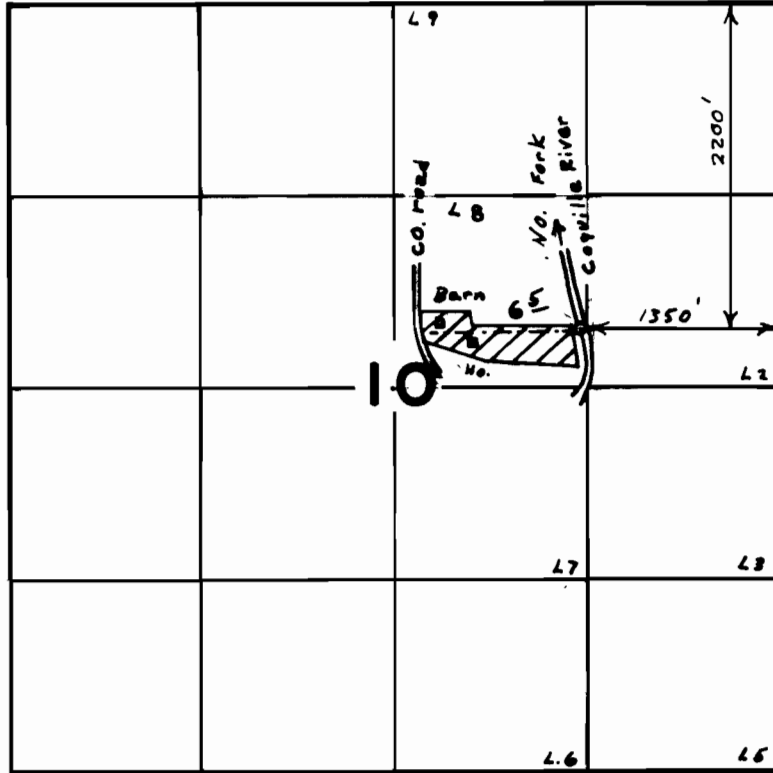

SCALE : 4" = 1 mile

FINAL PROOF SURVEY UNDER

Application No. 50735... Permit No. 38319....
IN NAME OF

.....JAMES.....RAY.....KRANTZ.....

Surveyed SEPT. 26 | 1979, by S. DONALDSON