


T.27 S. R.13 W. W.M.

SEC. 1

N 1/2 SW 1/4

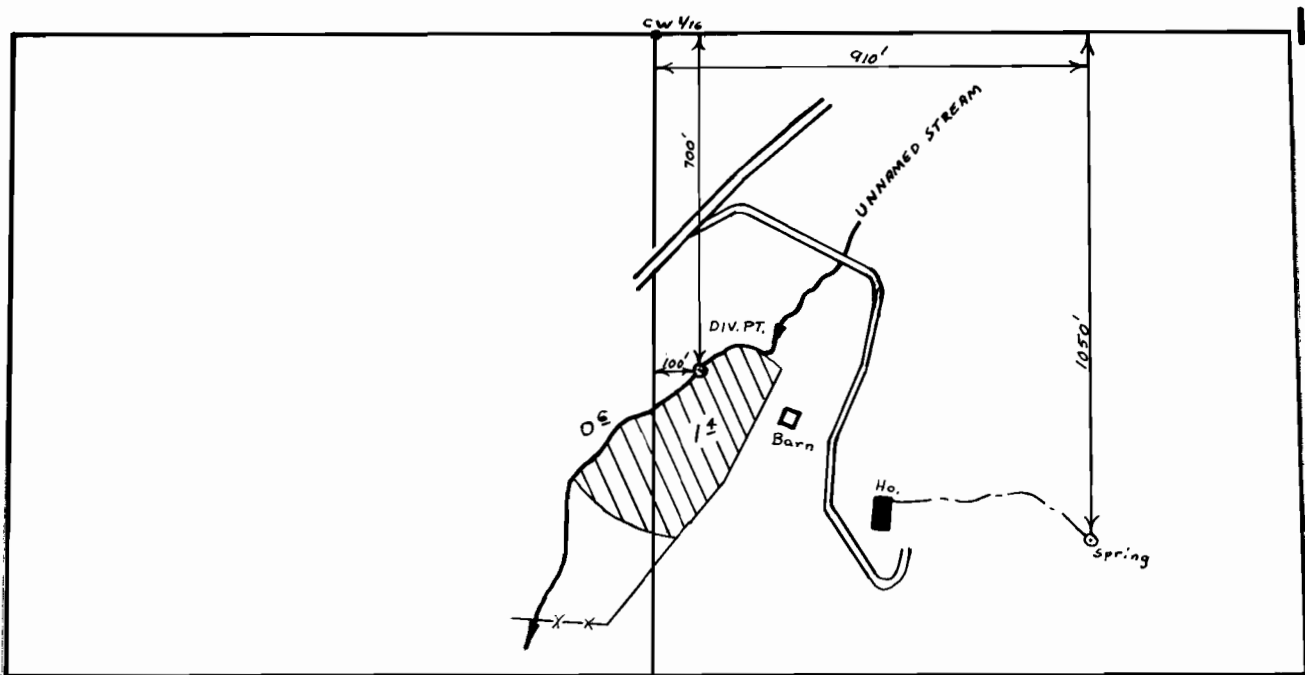

SCALE: 1" = 400'

**FINAL PROOF SURVEY
UNDER**

Application No. 52544 Permit No. 39811.....
IN NAME OF

.....LONNIE.....R.....HAMPTON.....

Surveyed SEPT. 11, 1979, by S. DONALDSON