


T. 29 S., R. 12 W., W. M.

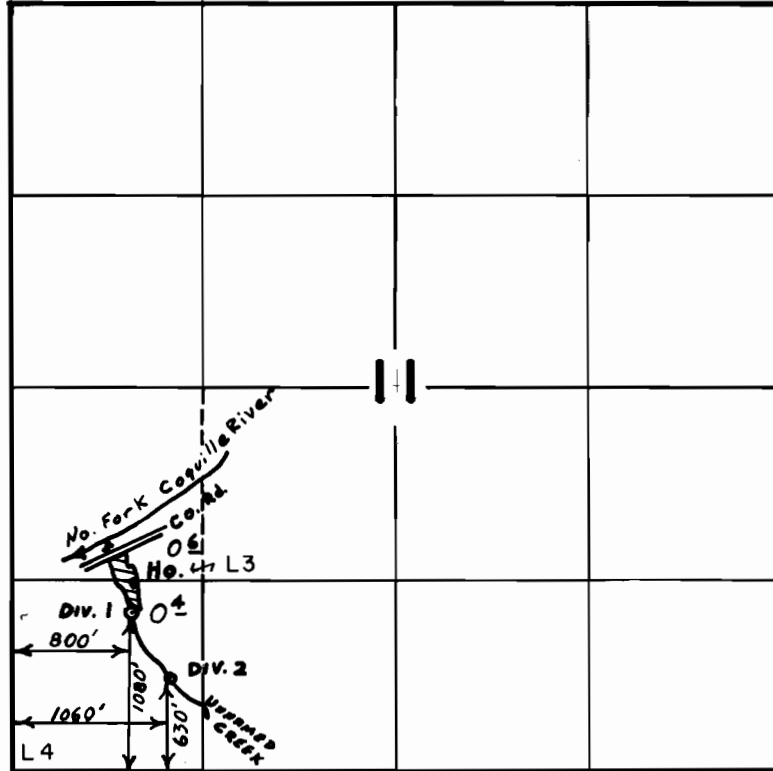

SCALE : 4" = 1 mile

FINAL PROOF SURVEY UNDER

Application No. 52669... Permit No. 39825...
IN NAME OF

.....DANIEL...D...&...LINDA...J...ELLIS.....

Surveyed 9-27-1979, by S. DONALDSON