


T.31S., R.12W., W.M.

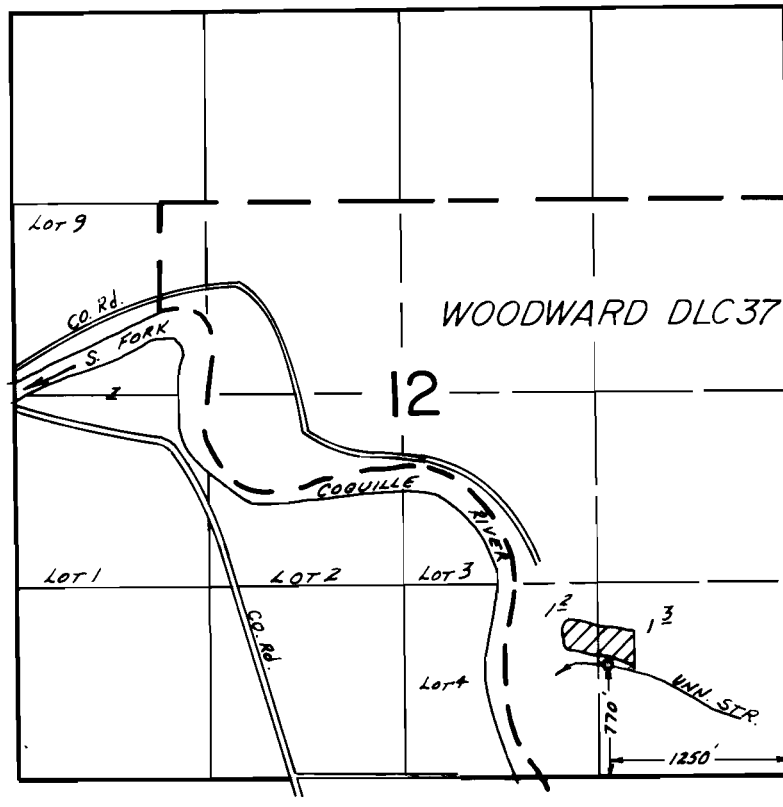

FINAL PROOF SURVEY
UNDER

Application No. 53655.. Permit No. 40124.....
IN NAME OF

.....CLAUDE ROBERT AIKEN.....

Surveyed JULY 23.. 19 80, by J.S. DONALDSON