


T. 28 S., R. 14 W., W.M.

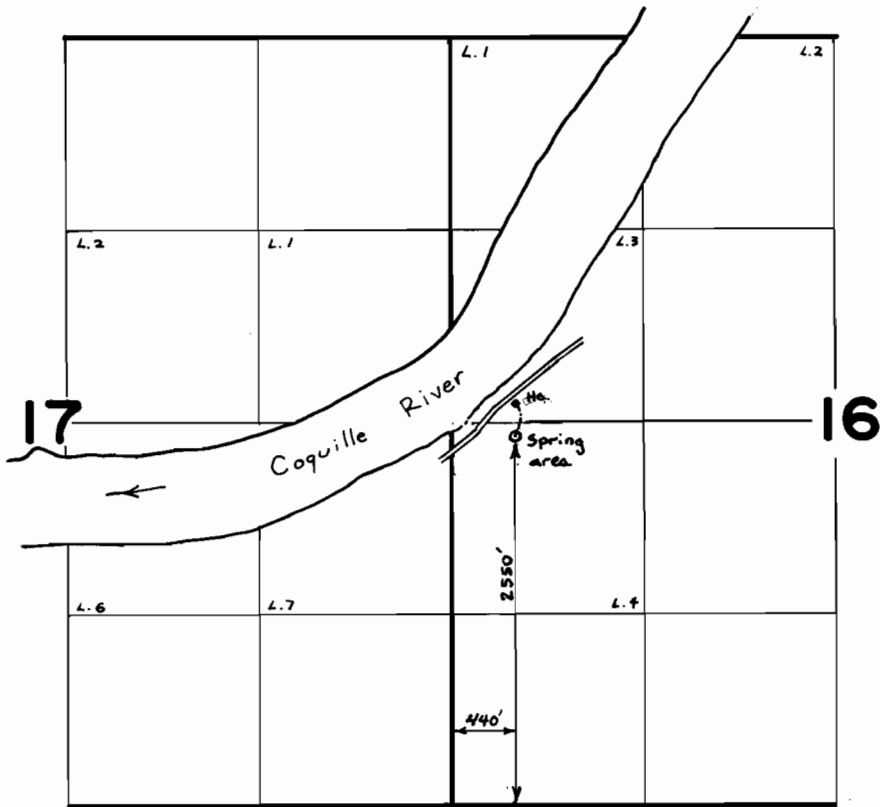

SCALE 4" = mile

FINAL PROOF SURVEY
UNDER

Application No. 55445. Permit No. 41822.
IN NAME OF

HARRY A. & FLORENCE N. KEMP.

Surveyed June 11, 1979, by S. Donaldson.