


T. 28 S. R. 12 W. W. M.

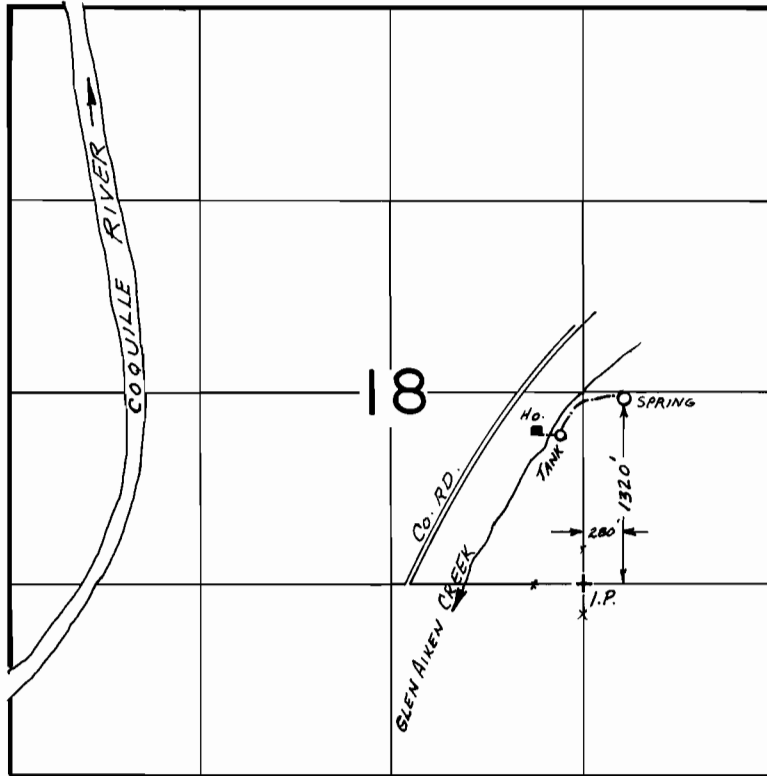

**FINAL PROOF SURVEY**  
UNDER

Application No. 56338.. Permit No. 42171.....  
IN NAME OF

RICHARD H. MORIN.....

Surveyed JULY 24.. 1980.. by J. S. DONALDSON