


T.27S., R.12W., W.M.

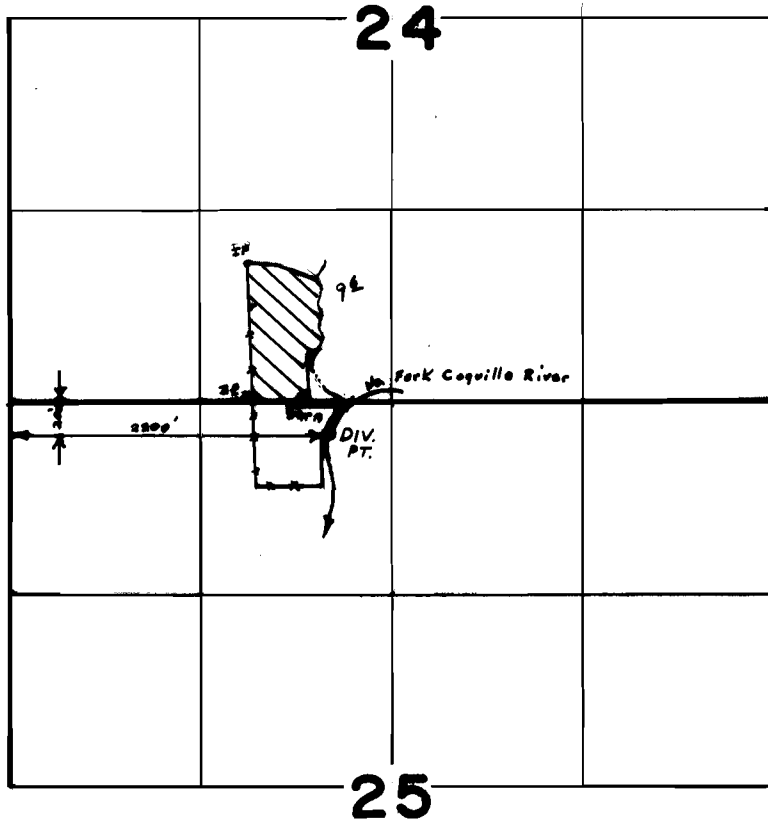

**FINAL PROOF SURVEY**  
UNDER

Tr. No. 3776

Application No. 56580.. Permit No. 42564.  
IN NAME OF

.....DUANE R. HARMER.....

Surveyed O.C.I. 9, 1979, by S. DONALDSON