


**T. 27 S., R. 13 W., W.M.**

34 35

3

2

LOT 4 (NW 1/4 NW 1/4)

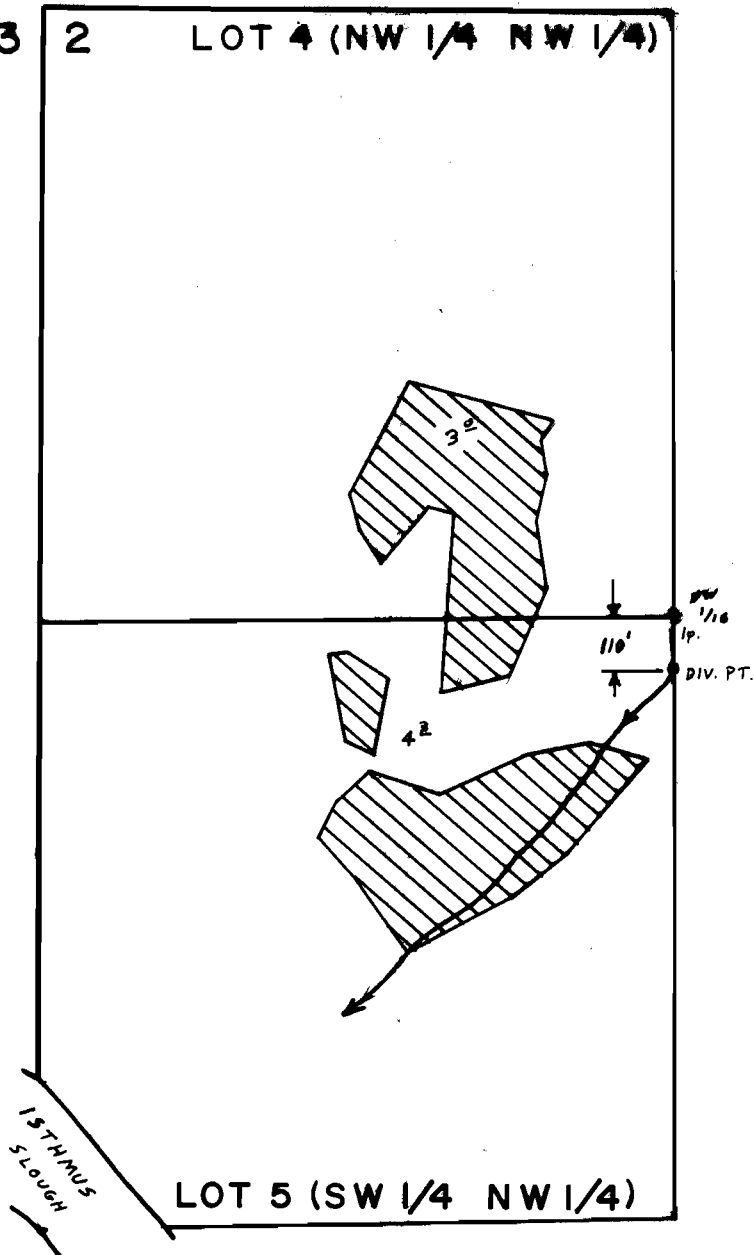

LOT 5 (SW 1/4 NW 1/4)

SCALE · 1" = 400'

**FINAL PROOF SURVEY**  
UNDER

Application No. 55863... Permit No. 42679.  
IN NAME OF

.....MIKE W. SIGLIN.....

Surveyed SEPT. 11, 1979, by S. DONALDSON