


T.28S., R.14 W., W.M.

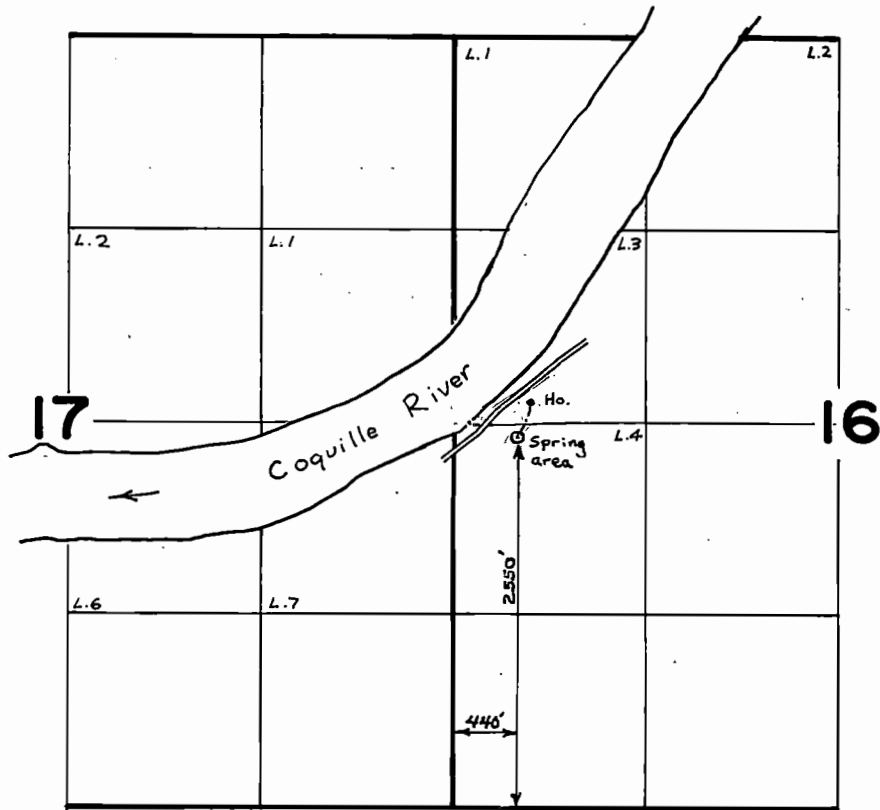

SCALE 4" = 1 mile

FINAL PROOF SURVEY
UNDER

Application No. 56937... Permit No. 42684
IN NAME OF

..... W. C. WYCOFF

Surveyed June 11, 1979, by S. Donaldson..