


RECEIVED
SEP 11 1978
WATER RESOURCES DEPT.
SALEM, OREGON

T25S R12W
SE 1/4 SW 1/4
Sec 19

NO CULVERT FOUND UNDER
ROAD. EXACT ROUTE FROM
THIS POINT UNCERTAIN.

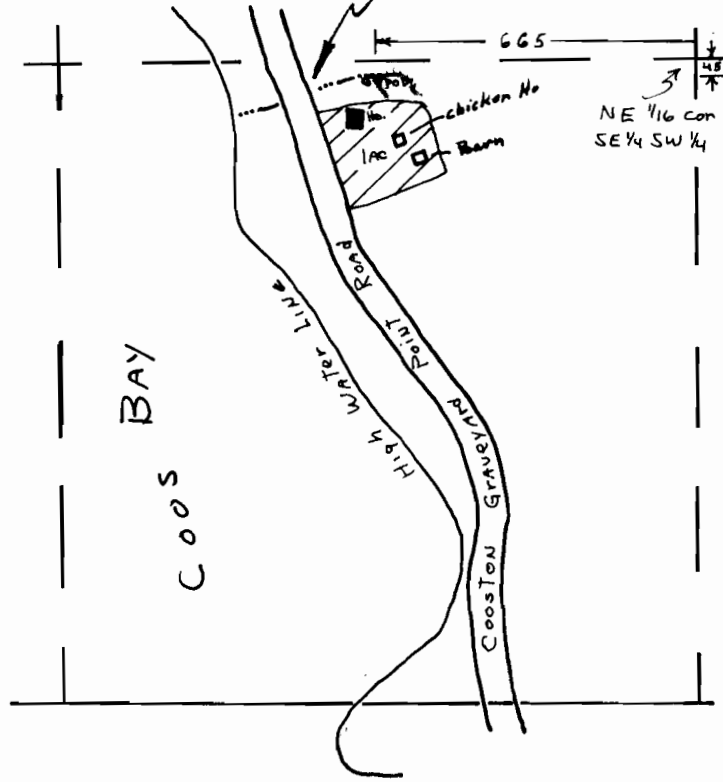

Application No. 57905
Permit No. 43694