


T. 23S., R. 12W., W.M.

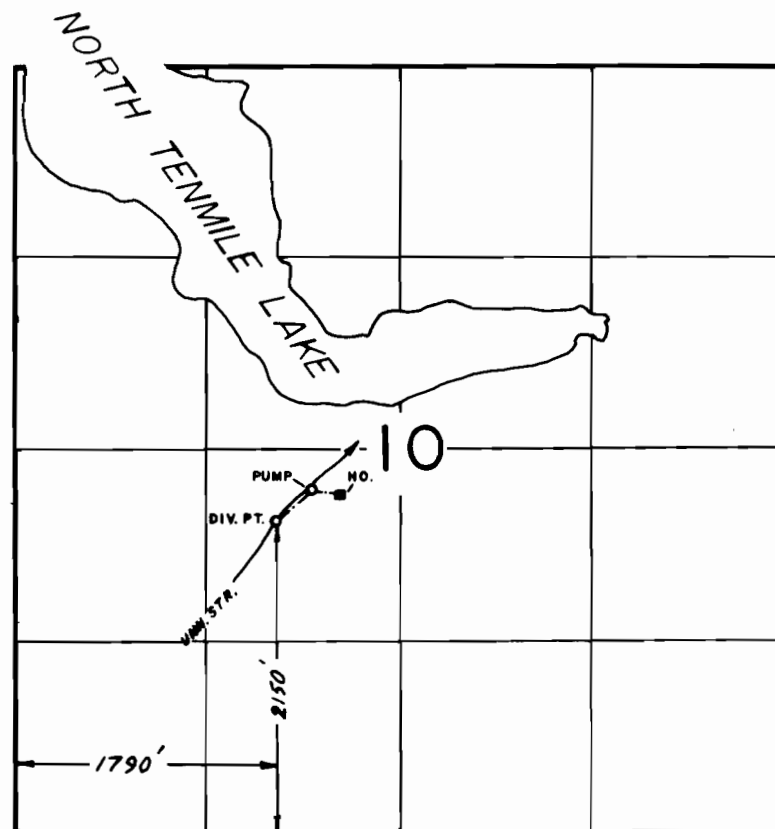

FINAL PROOF SURVEY
UNDER

Application No. 58194... Permit No. 43851.....
IN NAME OF

.....CLARENCE EDLER.....

Surveyed JUNE 18.. 19.80., by J.S. DONALDSON