


T. 28S., R. 12W., W.M.

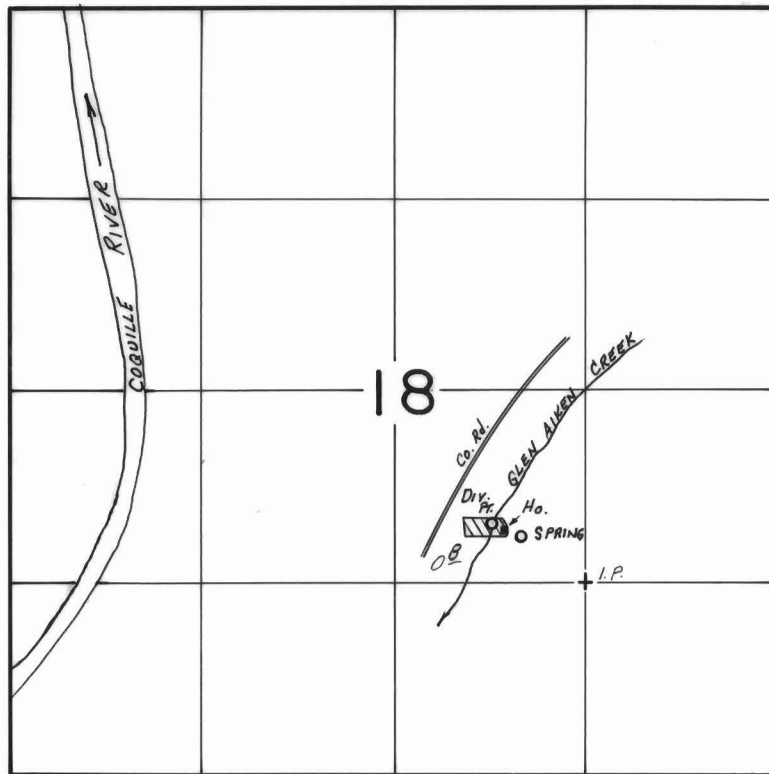

DIV. PTS. LOC.: SPRING-310'N & 440'W.; CREEK-400'N. & 640'W., BOTH FROM SE COR. NW¹/₄ SE¹/₄ SEC. 18.

FINAL PROOF SURVEY
UNDER

Application No. 58304. Permit No. 44182.....
IN NAME OF

.....WILLIAM P. JONSSON.....

Surveyed JULY 24, 1980, by J. S. DONALDSON