


T.26S., R.11W., W.M.

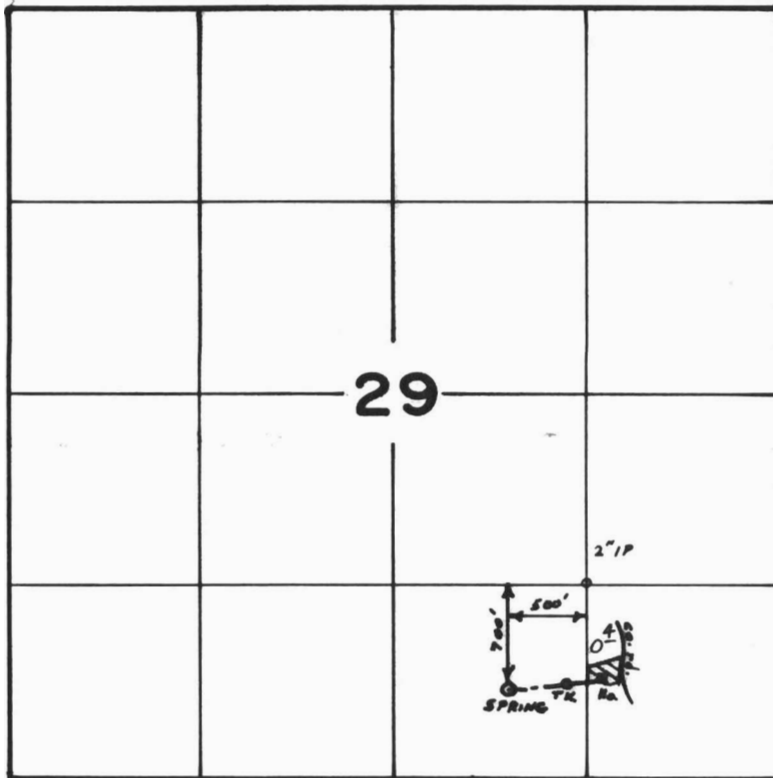

SCALE : 4" = 1 mile

FINAL PROOF SURVEY
UNDER

59016 44453
Application No. 55328.. Permit No. 41490..
IN NAME OF

.....**CECIL PETERSON**.....

Surveyed O.C.T. 9, 1979, by S. DONALDSON