



C-53799

T. 21 S., R. 20 E., W.M.

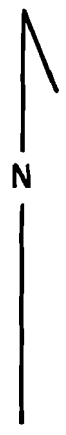

SCALE: 1" = 1320'

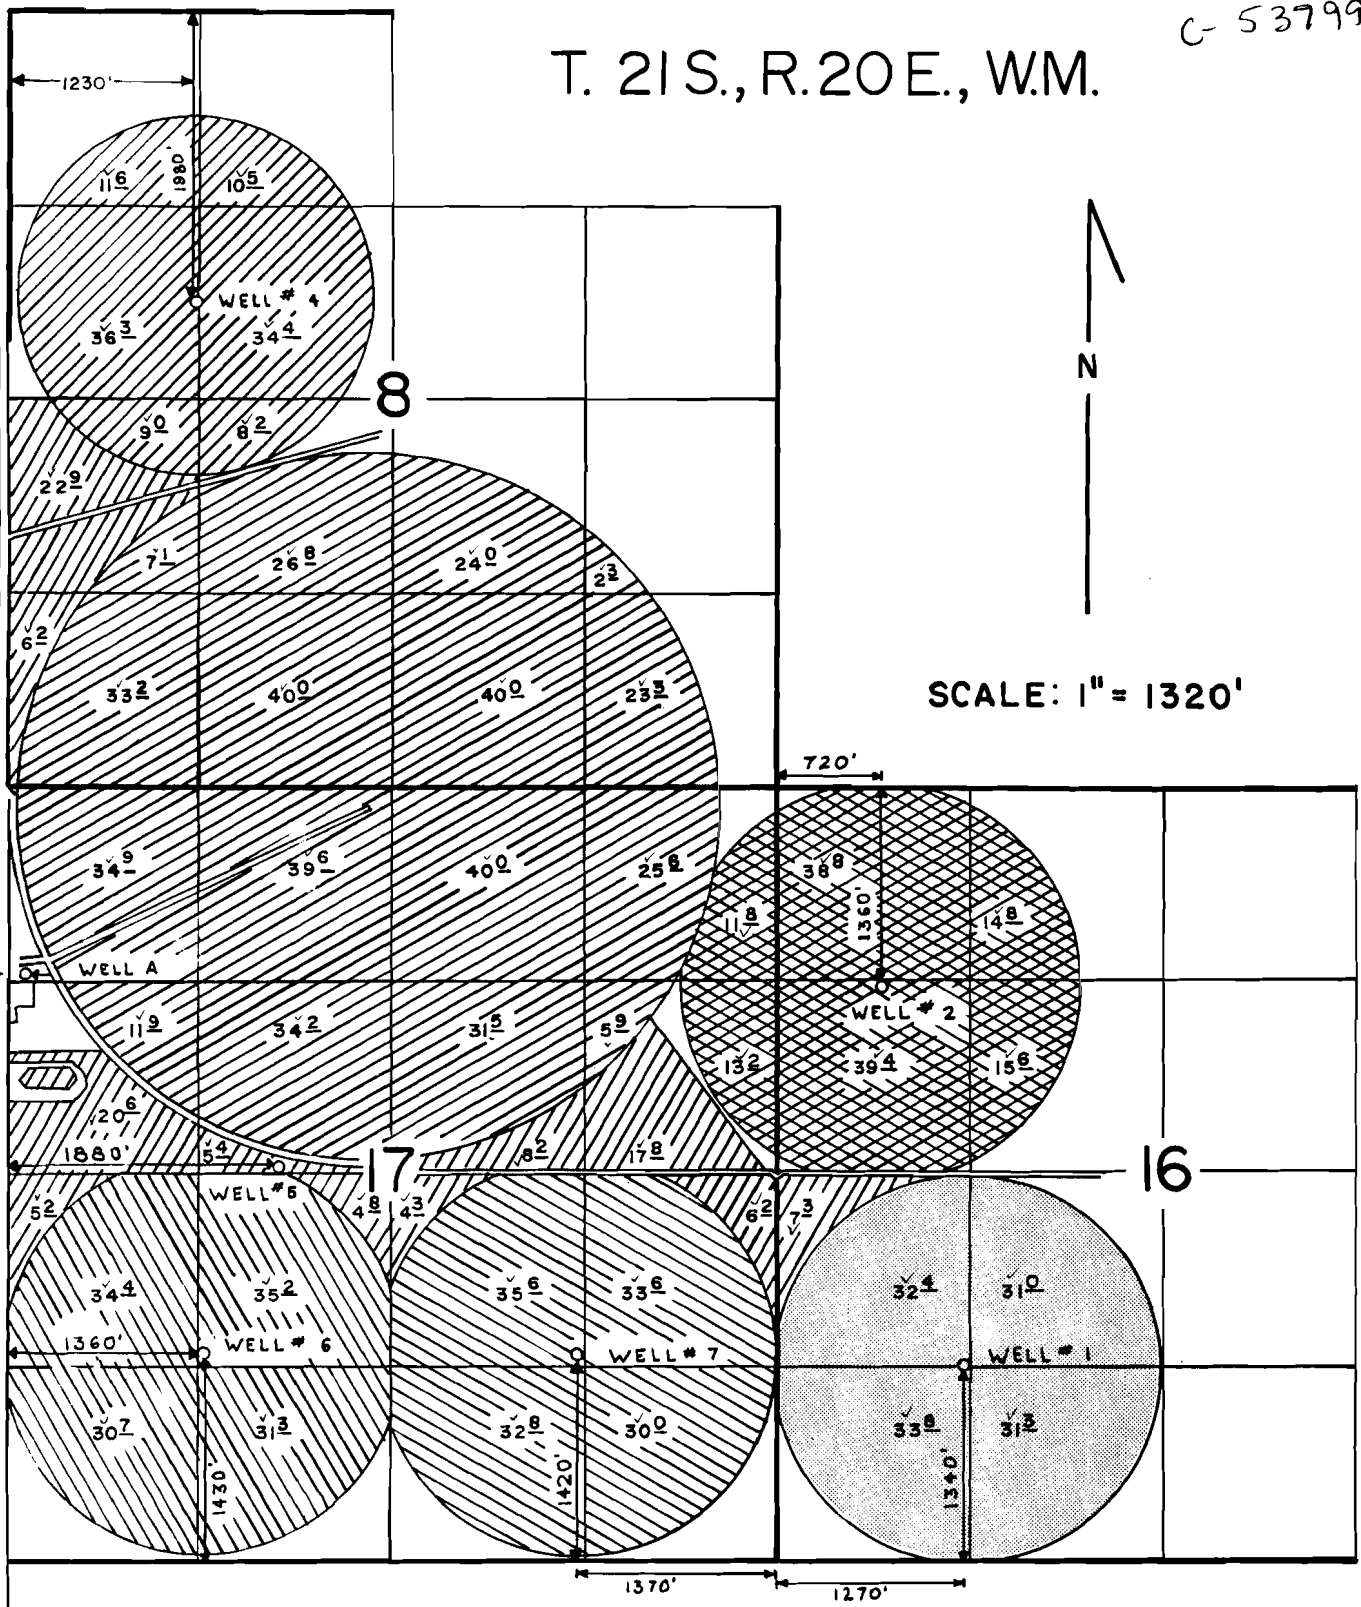

CERTIFICATE

APPLICATION	PERMIT	
-------------	--------	--

- | | | |
|---------|--------|----------|
| G-10494 | G-9663 | WELL # 1 |
| G-10495 | G-9664 | WELL 2 |
| G-10497 | G-9666 | WELL 4 |
| G-10498 | G-9667 | WELL 5 |
| G-10499 | G-9668 | WELL 6 |
| G-10500 | G-9669 | WELL 7 |
| G-9866 | G-9397 | WELL A |

FINAL PROOF SURVEY

IN NAME OF

ROBERT L. COATS

Surveyed AUG. 26, 27, 1985, by LESLIE OLSON

9397
69806

53799