


T. 21 S., R. 20 E., W.M.

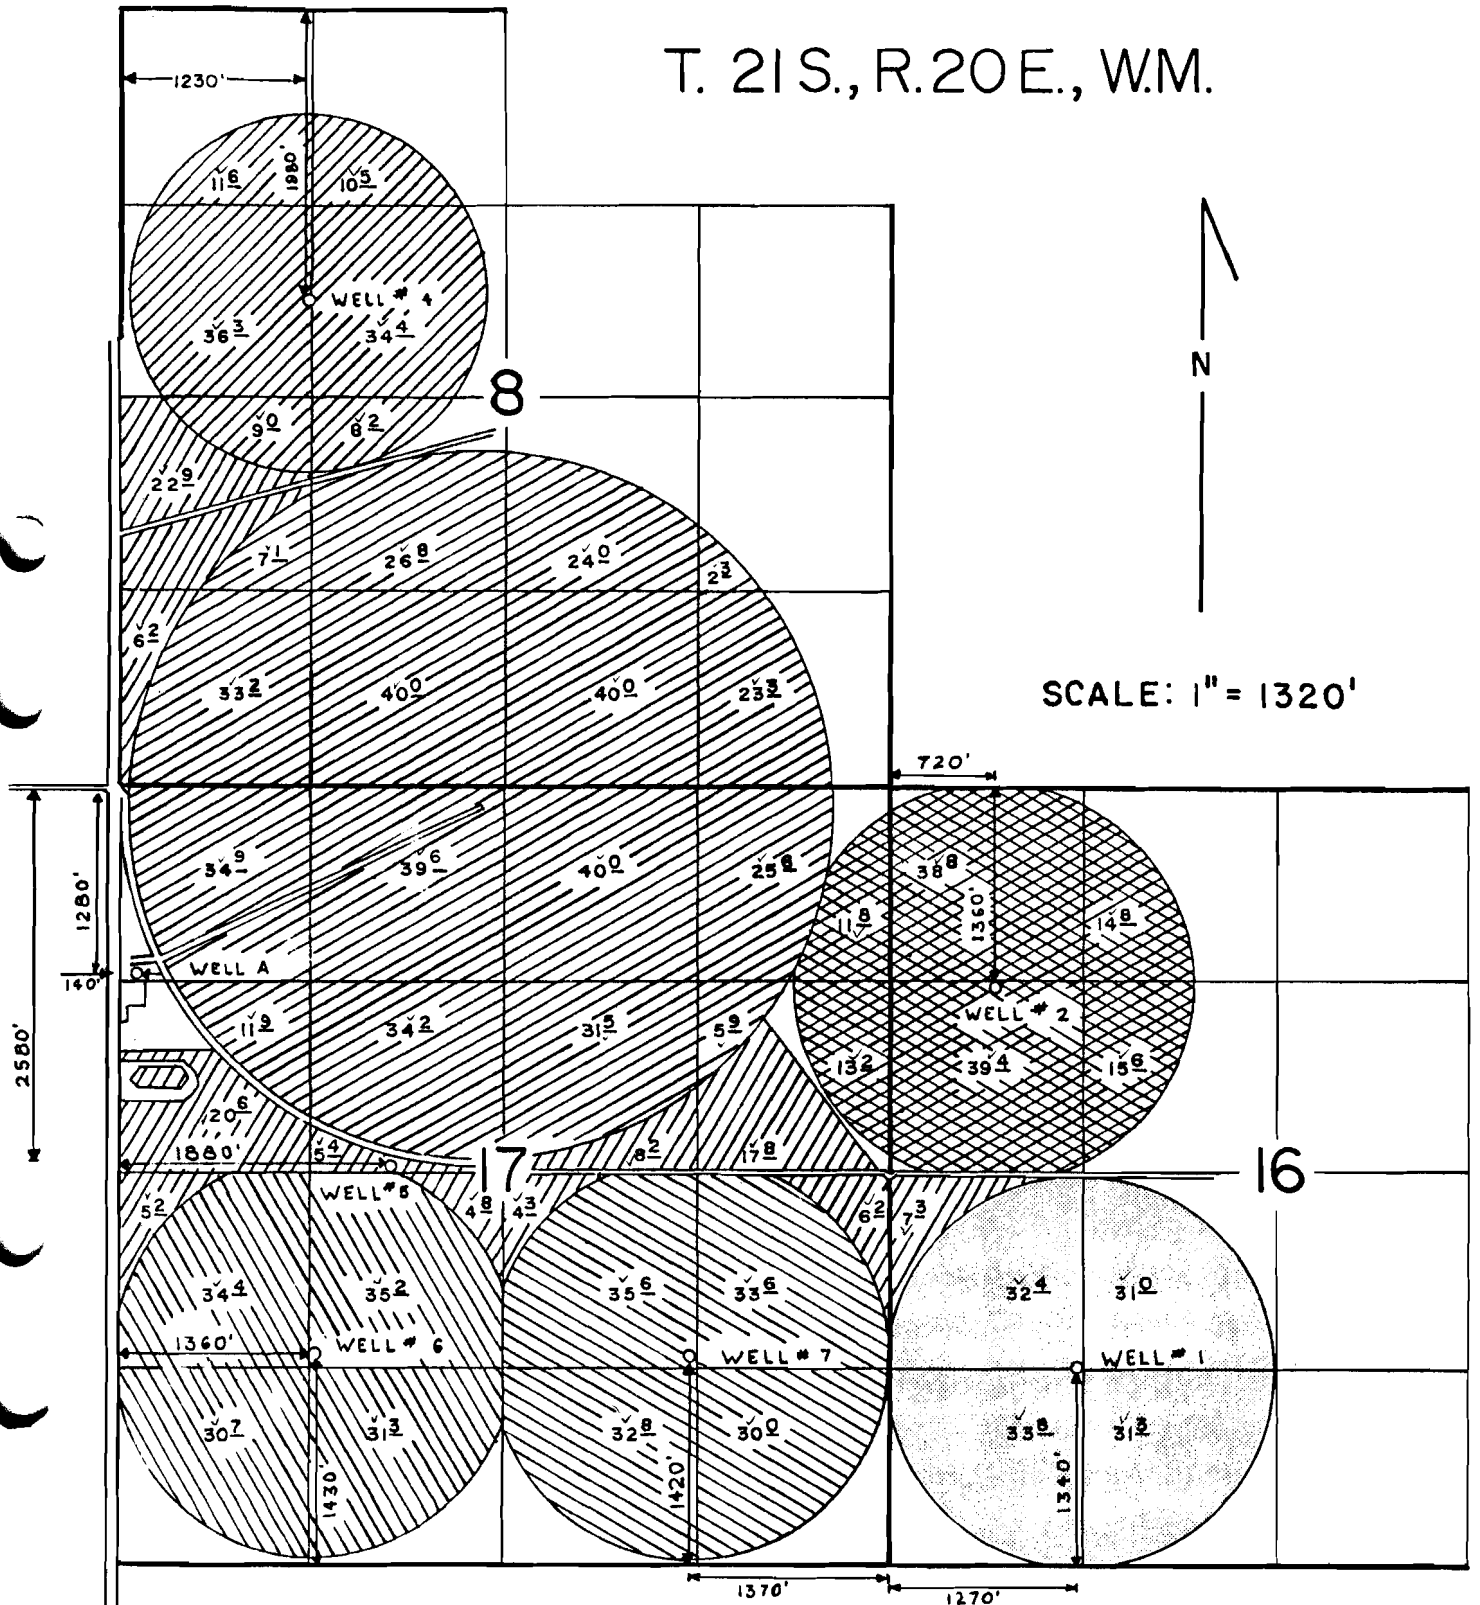

SCALE: 1" = 1320'



CERTIFICATE

53800  
53801

APPLICATION	PERMIT	
G-10494	G-9663	□ WELL # 1 53800
G-10495	G-9664	⊗ WELL 2 53801
G-10497	G-9666	▨ WELL 4
G-10498	G-9667	▧ WELL 5
G-10499	G-9668	▩ WELL 6
G-10500	G-9669	▪ WELL 7
G-9866	G-9397	▫ WELL A

FINAL PROOF SURVEY

IN NAME OF

ROBERT L. COATS

Surveyed AUG. 26, 27, 19 85, by LESLIE OLSON

G 9663 + G9664