


T. 21 S., R. 20 E., W.M.

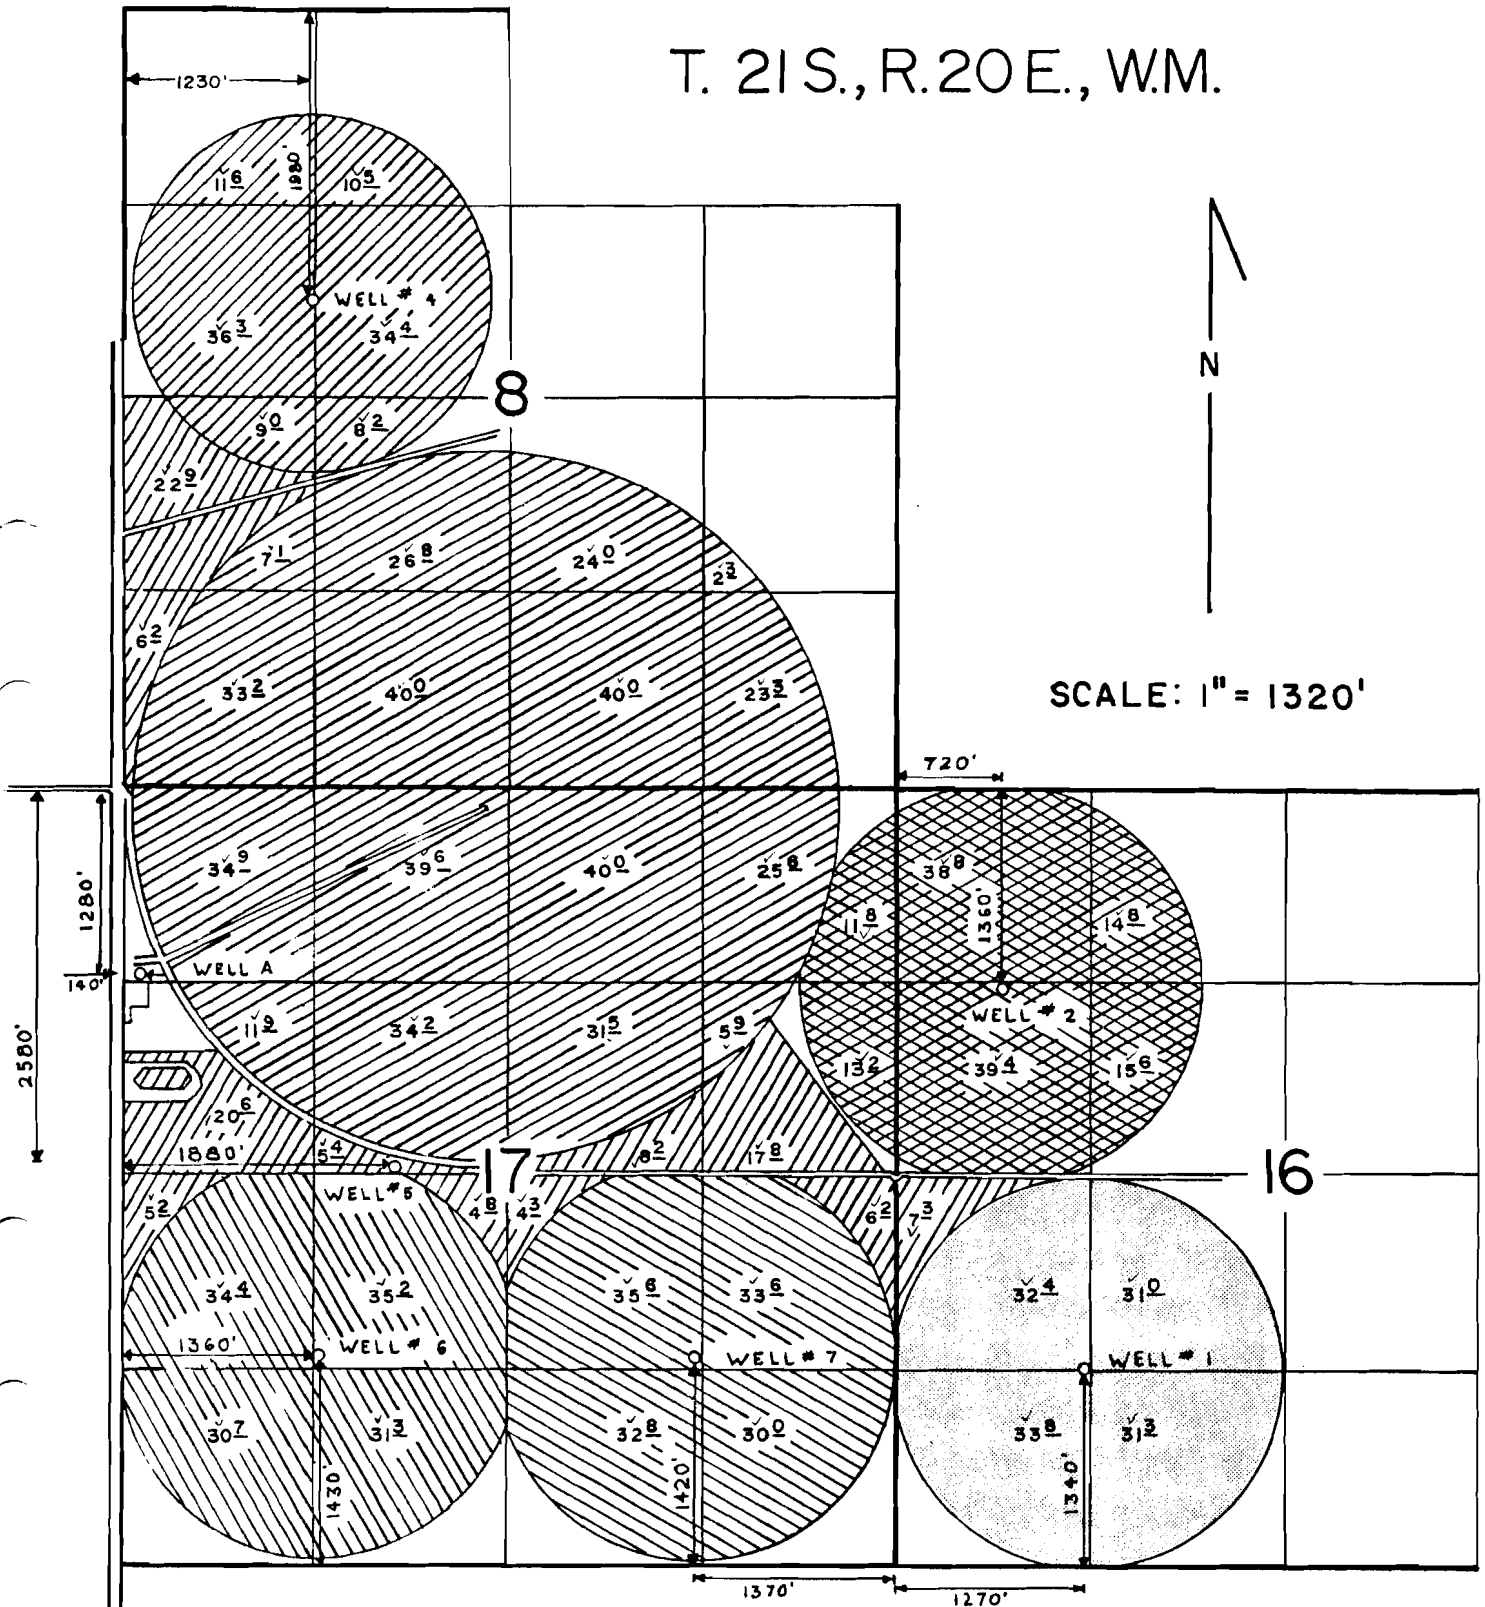

SCALE: 1" = 1320'

CERTIFICATE

APPLICATION	PERMIT		
G-10494	G-9663		WELL # 1
G-10495	G-9664		WELL 2
G-10497	G-9666		WELL 4
G-10498	G-9667		WELL 5
G-10499	G-9668		WELL 6
G-10500	G-9669		WELL 7
G-9866	G-9397		WELL A

FINAL PROOF SURVEY

53802  
53803  
53804  
53805

53802  
53803  
53804  
53805

IN NAME OF

ROBERT L. COATS

Surveyed AUG. 26, 27, 1985, by LESLIE OLSON

G9666  
G9667  
G9668  
G9669