


T. 38 S., R. 2 W., W.M.

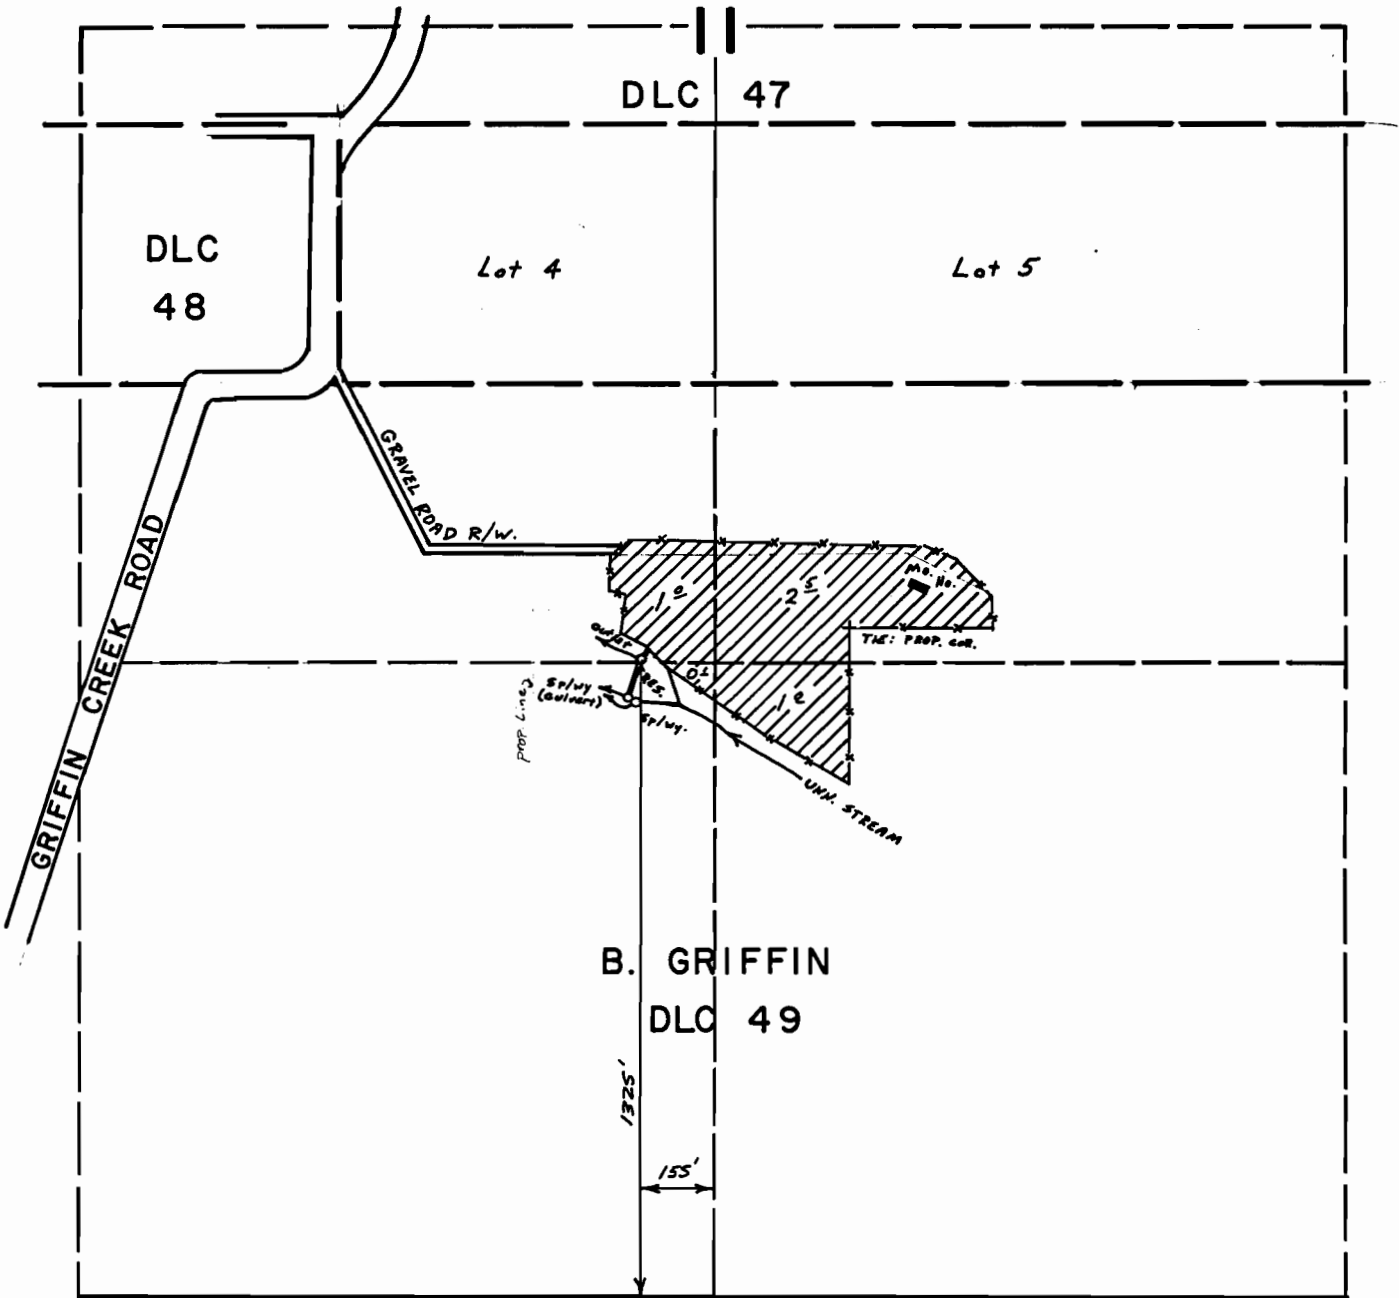

FINAL PROOF SURVEY
UNDER

R-48846 R-5926
Application No. **4884.7** Permit No. **3660.4**.....
IN NAME OF

.....LEON.....WILLOUGHBY.....

Surveyed **MAY 10, 1979**, by **B.R. SUND**.....

Scale 1" = 400'