


T. 38 S., R. 2 W., W.M.

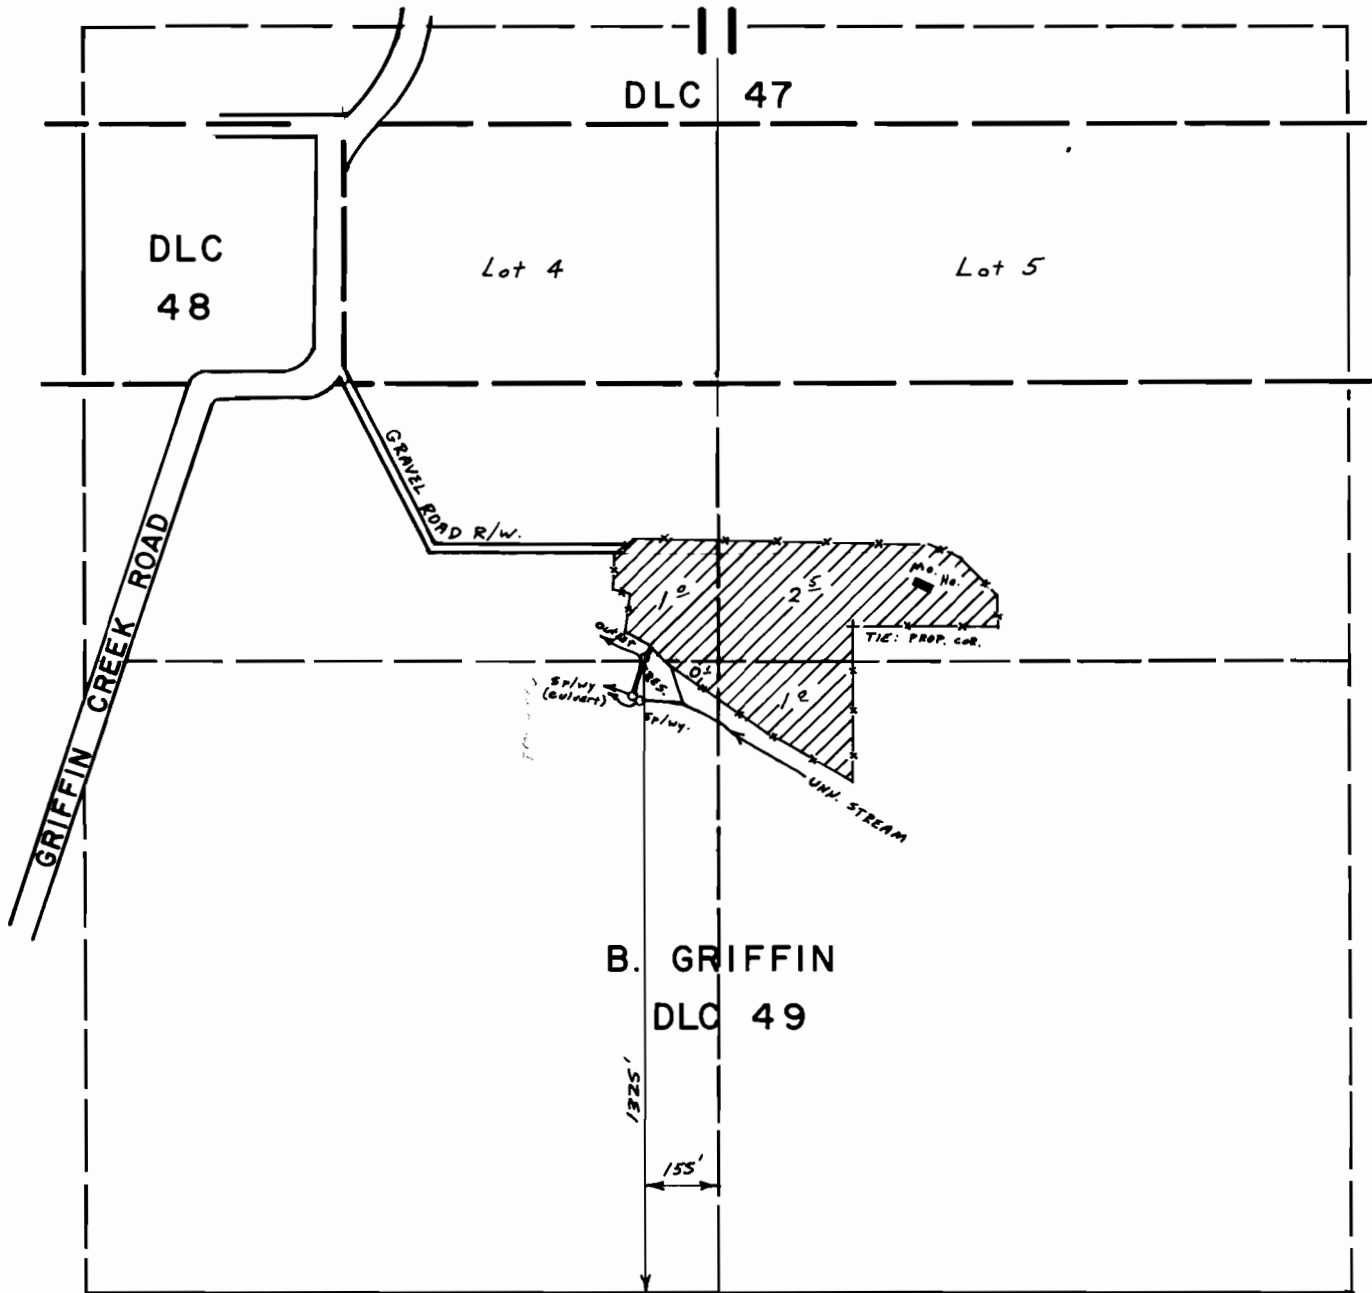

FINAL PROOF SURVEY UNDER

R-48846 R-5926
Application No. ~~4884.7~~ Permit No. 3660.4....
IN NAME OF

.....LEON.....WILLOUGHBY.....

Surveyed MAY.10, 1979, by B.R..SUND.....

Scale 1" = 400'