


T.36 S., R.4 W., W.M.

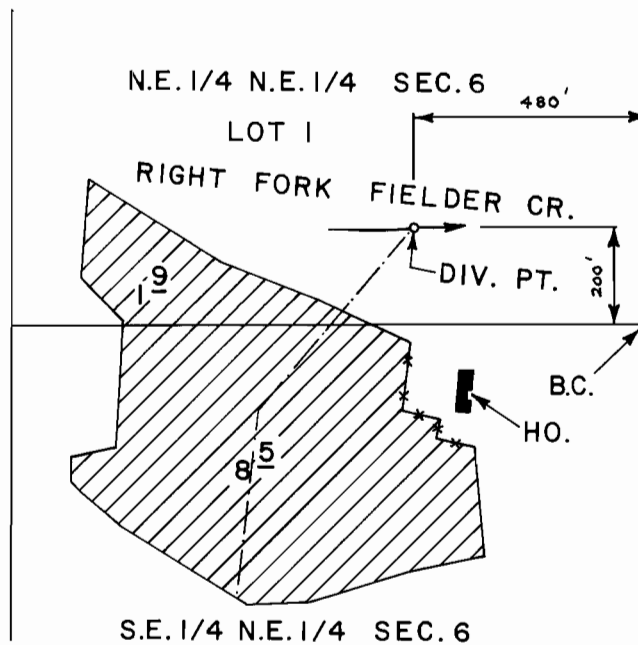

SCALE : 1" = 400 FT.

FINAL PROOF SURVEY UNDER

Application No. 49187 Permit No. 36873

IN NAME OF

MARNETTE R. PEEK

Surveyed APR. 19 19.79, by B. SUND

D.H.M.

P.T.S. - 1979 - 14 - A