


T.38 S., R.2 W., W.M.

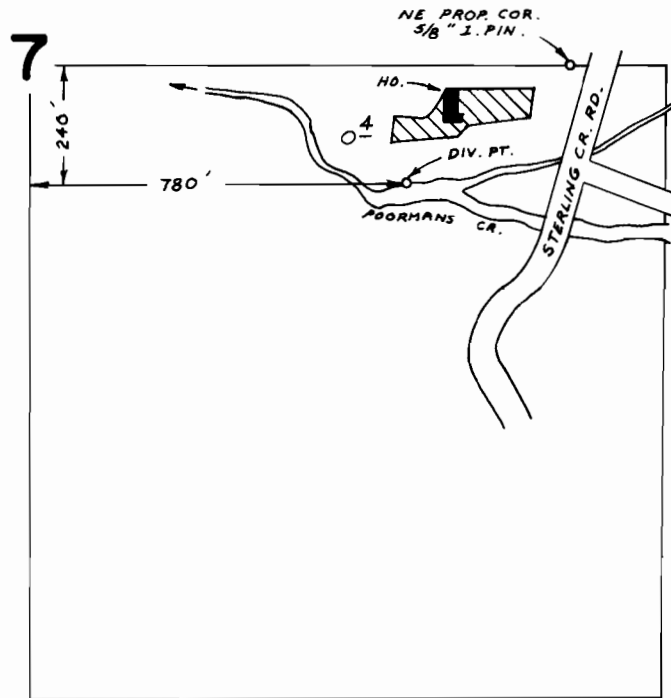

SCALE: 1" = 400 FT.

FINAL PROOF SURVEY
UNDER

Application No. 50163 Permit No. 37683
IN NAME OF

JEANETTE DAY

Surveyed MAY 11 1979, by B. SUND