


**T. 35 S., R. 1 W., W.M.**

**SEC. 17**

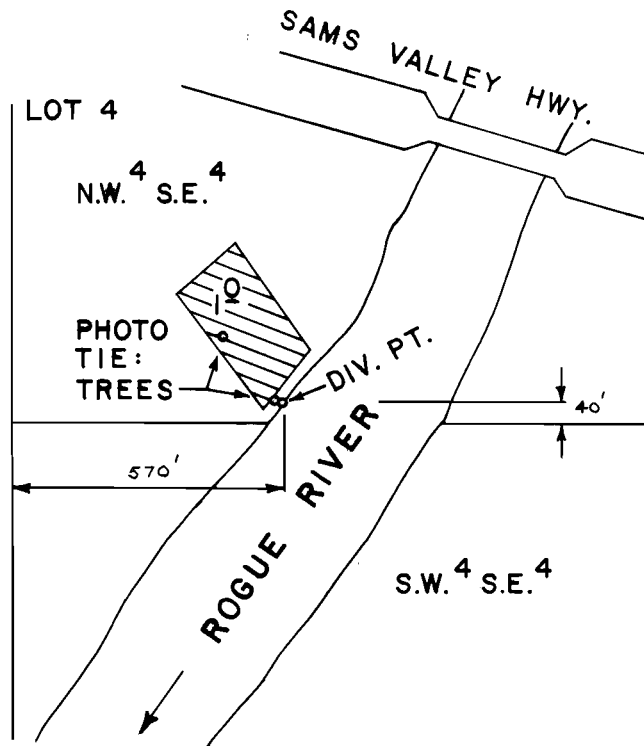

SCALE: 1" = 400 FT.

**FINAL PROOF SURVEY  
UNDER**

Application No. 56279 Permit No. 42141  
IN NAME OF

J.A. & T.E. WINEINGER

Surveyed MAY 15 1979, by B. SUND

D.H.M.  
P.T.S. - 1979-14-A  
BAX-3AA-59