


T. 39 S., R. 3 W., W.M.

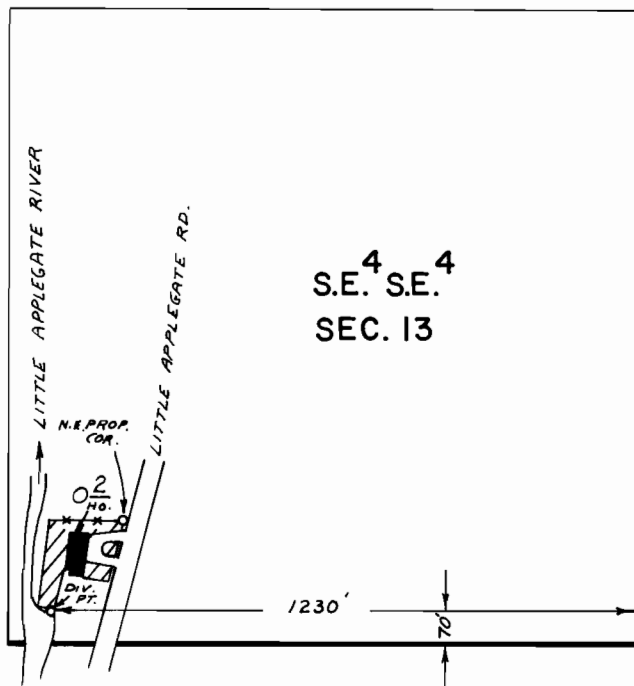

SCALE : 1" = 400 FT.

FINAL PROOF SURVEY
UNDER

Application No. 57493 Permit No. 43270
IN NAME OF

OWEN C. SULLIVAN

Surveyed APR. 24 1979 by B. SUND