



T.32S., R.3E., W.M.

28

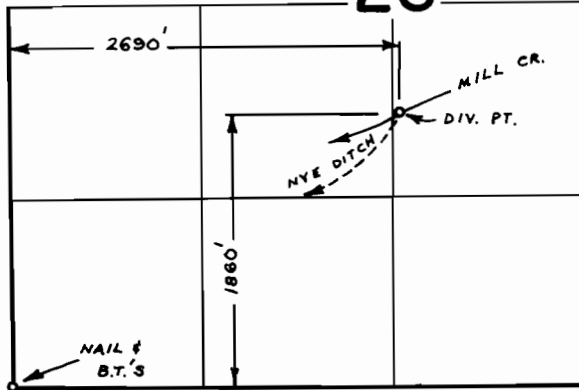

T.33 S., R.2 E., W.M.

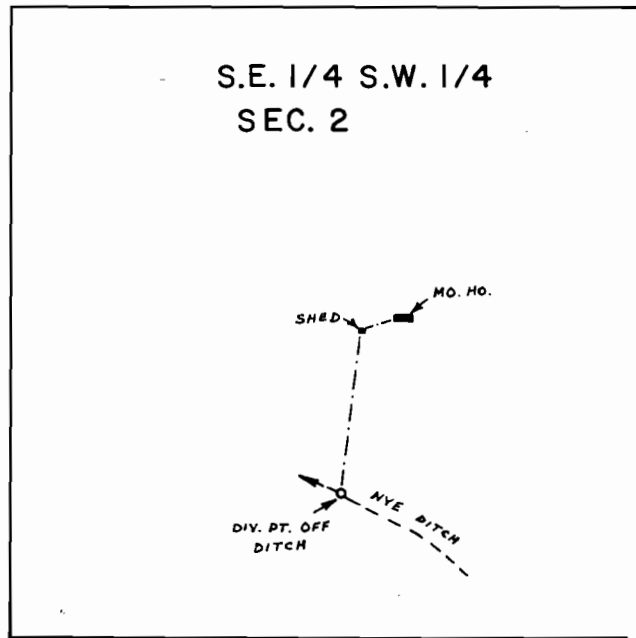

SCALE : 1" = 400 FT.

**FINAL PROOF SURVEY**  
UNDER

Application No. 57652 Permit No. 43425  
IN NAME OF

HAROLD R. &/OR LAURA R. HOLM

Surveyed JUN. 7 19.79, by B. SUND

D.H.M.  
P.T.S. - 1979-14-B  
P.T.S. - 1967L