


T. 33 S., R. 1 W., W. M.

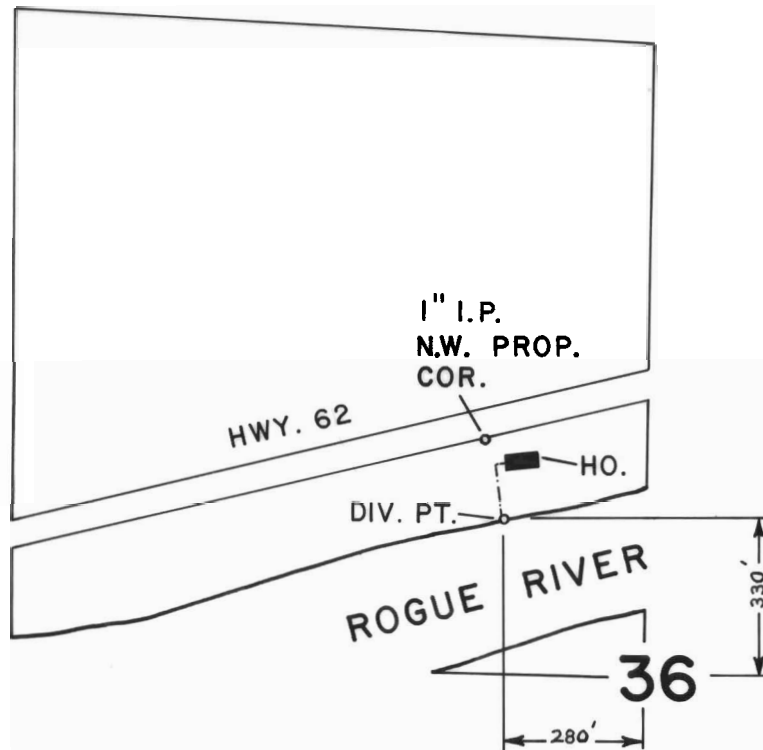

SCALE : 1" = 400 FT.

FINAL PROOF SURVEY
UNDER

Application No. 57973 Permit No. 43591
IN NAME OF

EVELYN BACON

Surveyed MAY 30 1979, by B. SUND

D.H.M.
P.T.S. - 1979 - 14 - B