


T. 36 S., R. 1 W., W.M.

Sec. 15

SW 1/4 SW 1/4

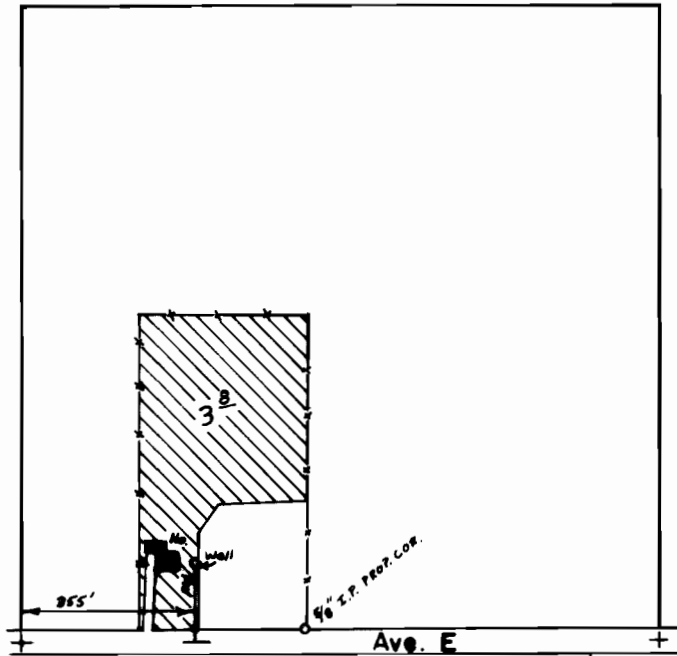

Scale 1" = 400'

FINAL PROOF SURVEY
UNDER

Application No. G-6031.. Permit No. G-5742
IN NAME OF

.....JAMES & ELSIE WILSON.....

Surveyed May 22, 1979, by B.R.SUND.....