


T. 38 S., R. 1 W., W.M.

SEC. 20

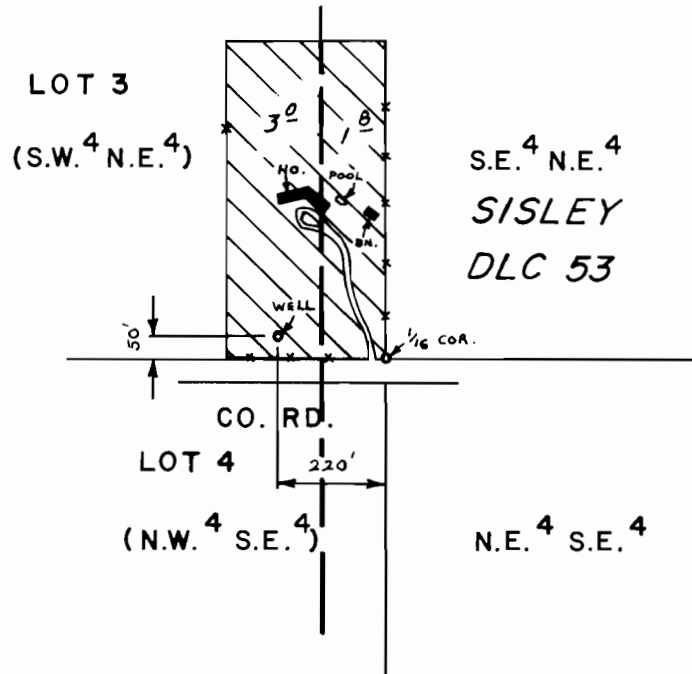

SCALE: 1" = 400 FT.

**FINAL PROOF SURVEY**  
UNDER

Application No. G-6271 Permit No. G-5904  
IN NAME OF

JOHN H. &/OR FRANCES G. LICHTENWALNER

Surveyed MAY 10 1979, by B. SUND

D.H.M.  
P.T.S. - 1979 - 14 - A