


T. 36 S., R. 1 E., W. M.

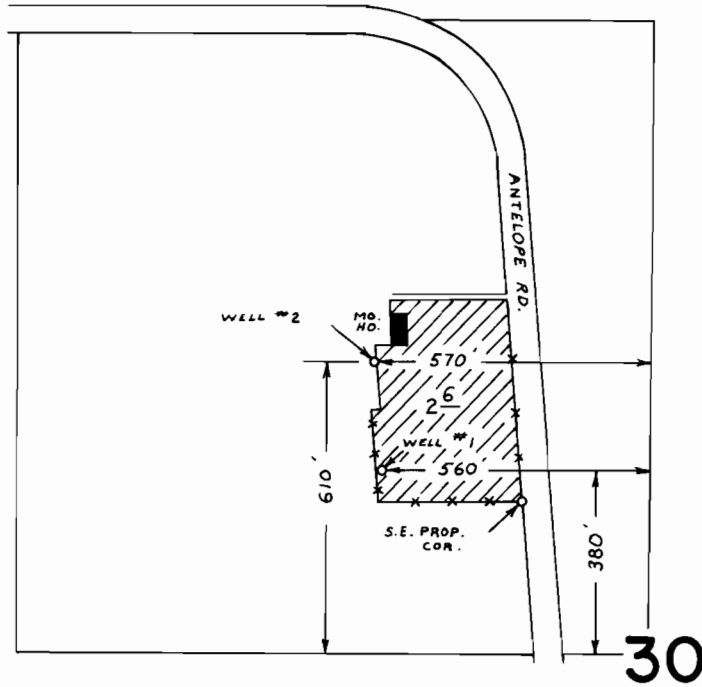

SCALE: 1" = 400 FT.

FINAL PROOF SURVEY UNDER

Application No. G-8085 Permit No. G-7704
IN NAME OF

LARRY RESH

Surveyed MAY 22 1979, by B. SUND