


T.39 S., R.6 W., W.M.

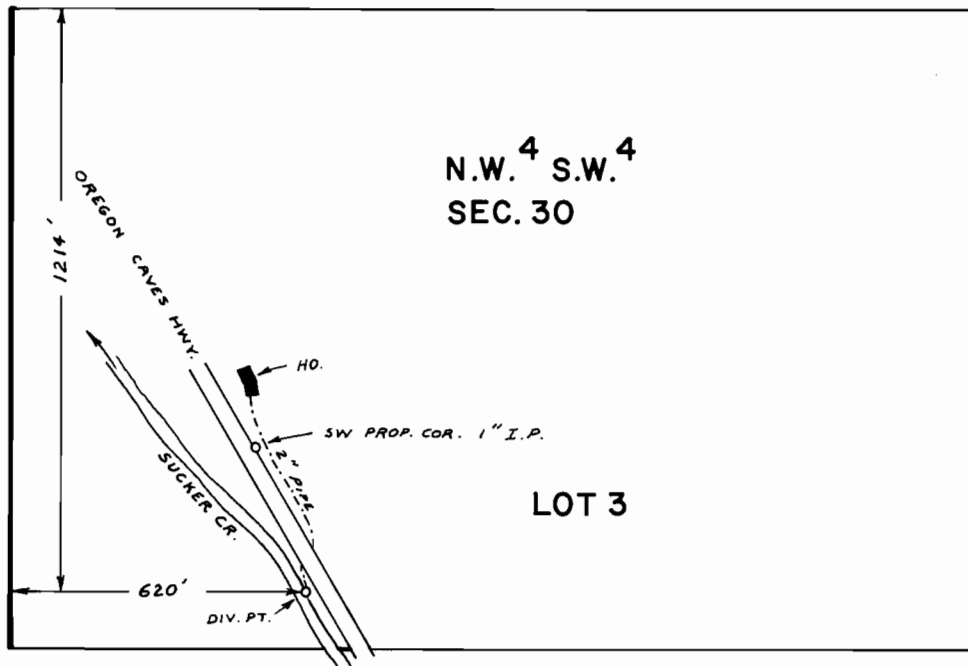

SCALE: 1" = 400 FT.

**FINAL PROOF SURVEY**  
UNDER

Application No. 44863 Permit No. 33547  
IN NAME OF  
KEN POLK

Surveyed JUN. 11 1979, by B. SUND