


T. 41 S., R. 9 W., W.M.

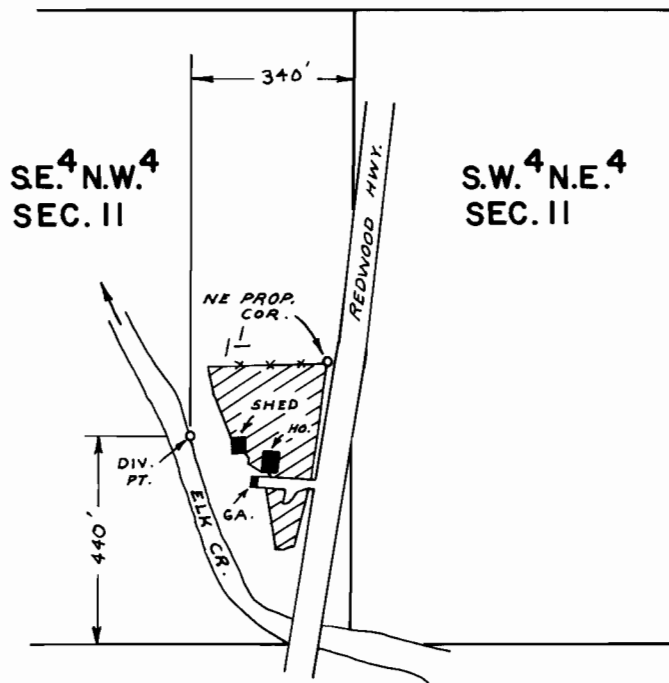

SCALE : 1" = 400 FT.

FINAL PROOF SURVEY
UNDER

Application No. 46950 Permit No. 35111
IN NAME OF
ERNEST W. OR DELLA B. WOLDERMAR
Surveyed JUN. 13 1979, by B. SUND