



T.37 S., R. 5 W., W. M.

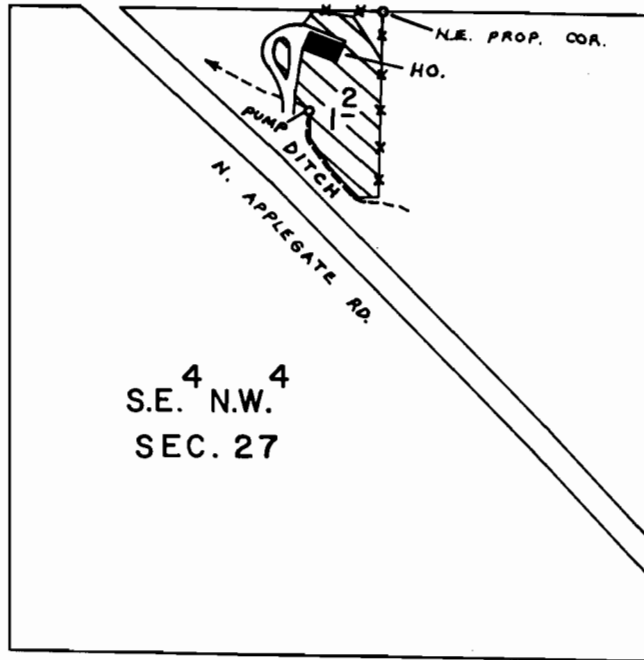

SCALE: 1" = 400 FT.

T.38 S., R. 4 & 5 W., W. M.

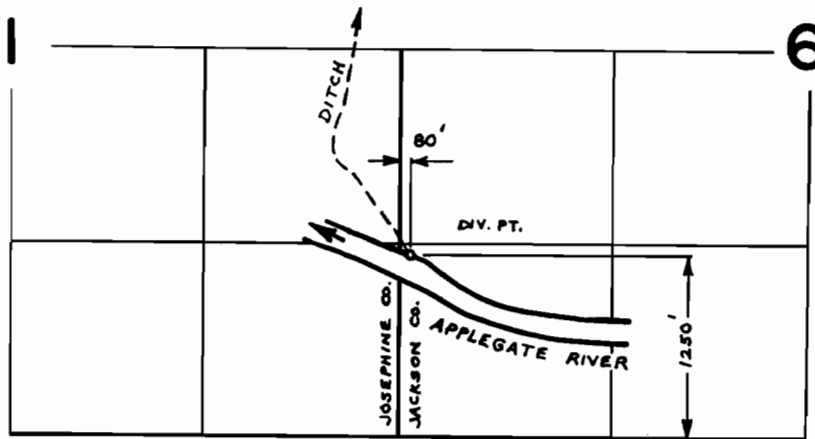

FINAL PROOF SURVEY
UNDER

Application No. 50766 Permit No. 37289
IN NAME OF

GERALD P. SORENSEN

Surveyed MAR. 29 19 79, by B. SUND

D.H.M.
P.T.S. - 1979 - 14 - A
& P.T.S. - 1967 - V