

RECEIVED

MAR 28 1975

STATE ENGINEER
SALEM, OREGON

16 15
21 22

17 16
20 21

B.L.M. — O. & C.

DILLON

MILLER

B.L.M. — O. & C.

COX

SET 5/8" I. ROD AT
POINT OF DIVERSION
(SPRING)

1946.82'
EAST

1705.55'
NORTH

SEC. COR.
BRASS CAP
& 4 B.T.'S.

20 21
29 28


21 22
28 27

Application No. 52903
Permit No. 39950

WATER LINE TRAVERSE

TRAVERSE NO.	BEARING.	DISTANCE
(HOUSE) 31	N 47° 39' 12" W	57.75'
32	N 59° 01' 00" W	133.54'
33	N 37° 16' 48" W	73.83'
34	N 33° 43' 36" W	154.41'

TRAVERSE NO.	BEARING	DISTANCE
35	N 57° 49' 42" W	109.81'
36	N 46° 17' 30" W	73.66'
37	N 53° 02' 36" W	128.82'
38	N 53° 02' 36" W	52.83'
PT. OF DIV.		

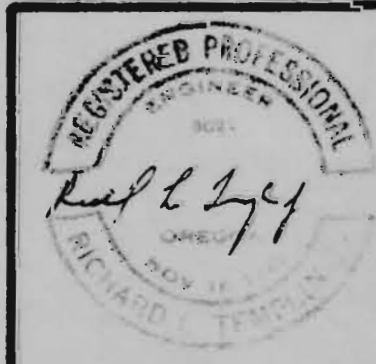

RICHARD L. TEMPLIN
CONSULTING ENGINEER

PLAT OF SURVEY
SURFACE WATER APPLICATION

LOCATED IN
SW 1/4 OF SECTION 21, T.33S., R.5W., W.M.
JOSEPHINE COUNTY, OREGON

Surveyed for: Mr. Jack Vaughn

Scale: 1" = 400'

Nov. 22, 1974.