


T. 35 S., R. 8 W., W.M.

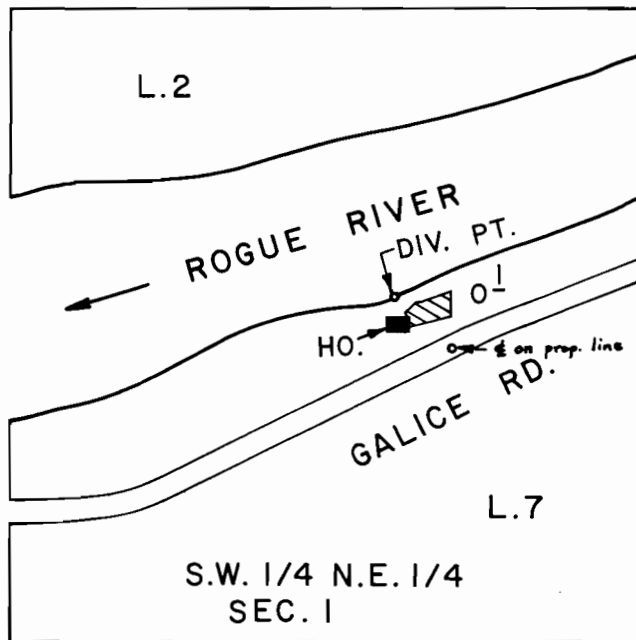

DIV. PT. LOC. - 720 FT. N. & 800 FT. E. FROM
CENTER OF SEC. 1.

SCALE: 1" = 400 FT.

FINAL PROOF SURVEY
UNDER

Application No. 52821 Permit No. 42664
IN NAME OF

H. M. FLY

Surveyed AUG. 14 1979, by B. SUND

D.H.M.
P.T.S.-1979-14-C