


T. 35 S., R. 8 W., W. M.

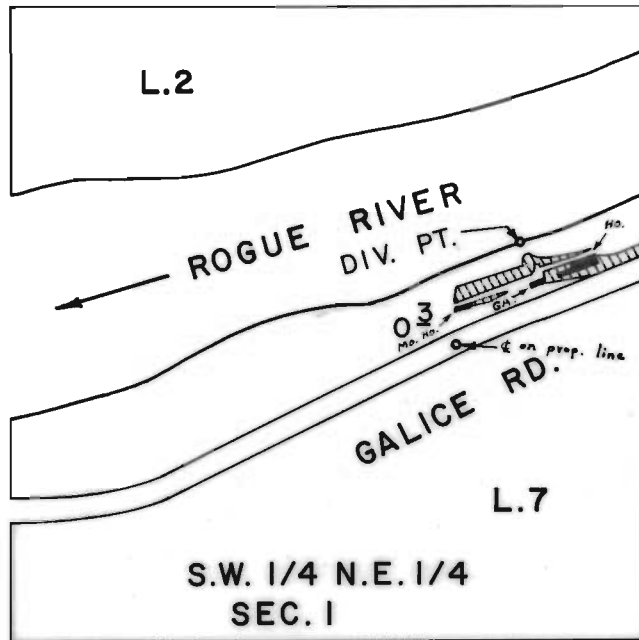

DIV. PT. LOC. - 830 FT. N. & 1050 FT. E. FROM  
CENTER OF SEC. 1.

SCALE : 1" = 400 FT.

**FINAL PROOF SURVEY**  
UNDER

Application No. 52822 Permit No. 42665  
IN NAME OF  
CARY F. FLY

Surveyed AUG. 14 1979, by B. SUND

D.H.M.  
P.T.S. - 1979-14-C