


T. 40 S., R. 8 W., W.M.

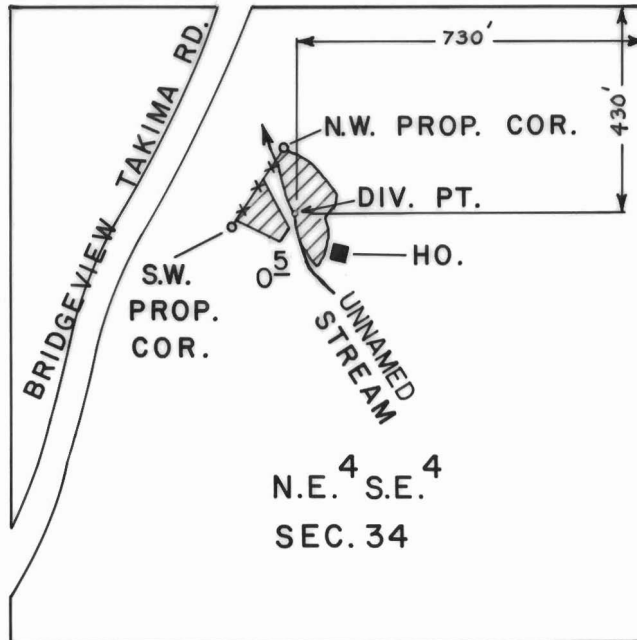

SCALE: 1" = 400 FT.

FINAL PROOF SURVEY UNDER

60065 44786

Application No. Permit No.
IN NAME OF

..... ELLEN H. SANDERS

Surveyed JUN. 13 1979, by B. SUND
AUG. 26 1982 BRUCE R. SUND

D.H.M.

P.T.S. - 1979 - 14 - B

T.W.B.

PTS-1982-14-A