


T.2N.R.2W.W.M.

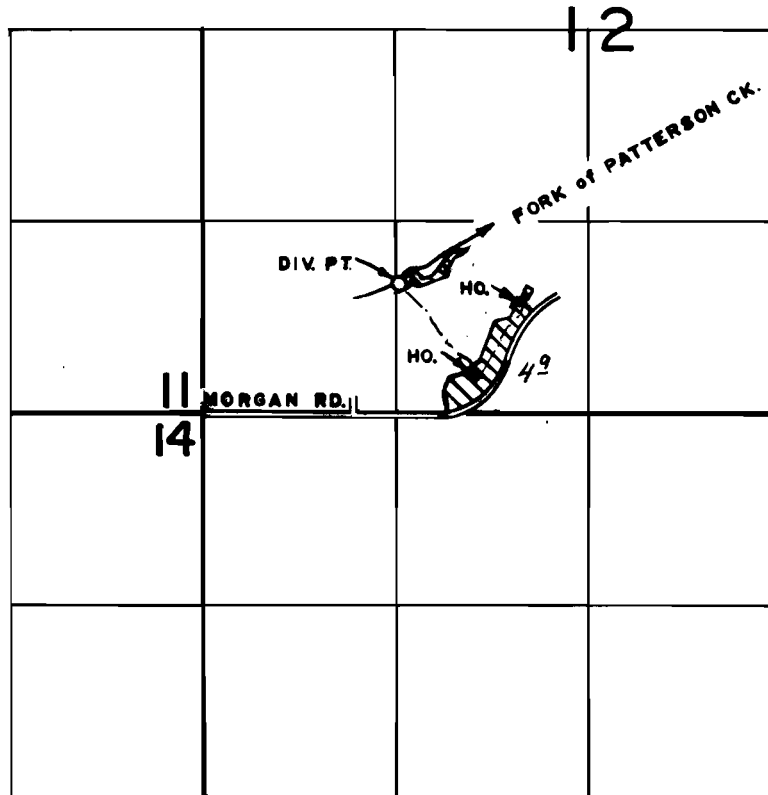

DIV. PT. LOC. 900' N. & 134.0' E. FROM S.W. COR. SEC. 12

FINAL PROOF SURVEY
UNDER

Application No. 52233 Permit No. 39317.....
IN NAME OF

TERRY A. VOLLERTSEN.....

Surveyed NOV 7 1979, by R.G. MUCKEN.....