


T.2N.R.5W.W.M.

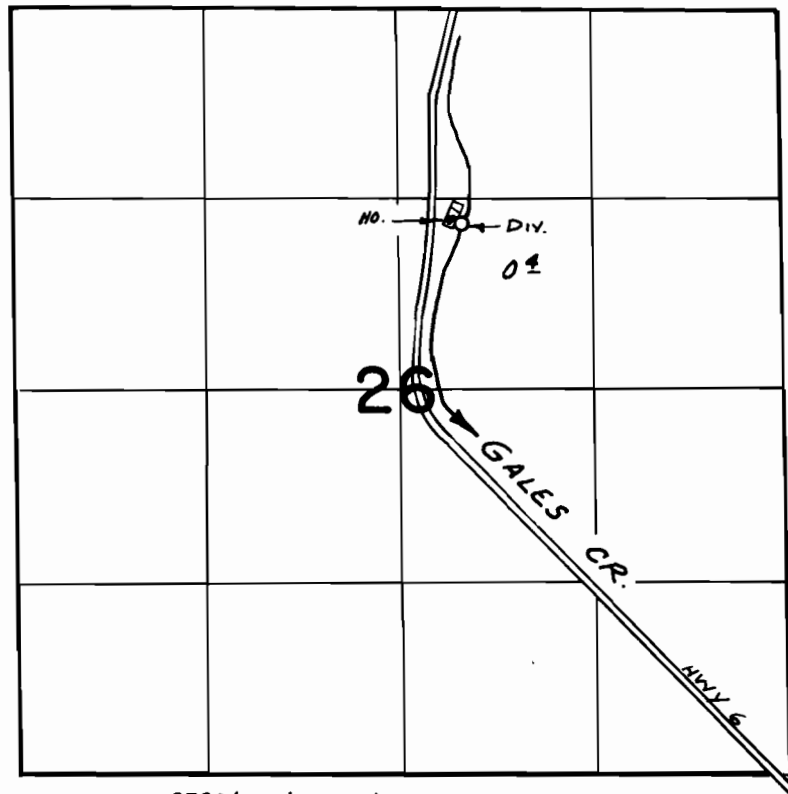

DIV. LOC: 3780'N. & 2180'W. FROM S.E. COR. SEC. 26

FINAL PROOF SURVEY UNDER

Application No. 52066. Permit No. 37793.....
IN NAME OF

.....EVELYN M. BYERS.....

Surveyed MAY 4, 1979., by R. MUGKEN