


T.1N.R.4W.W.M

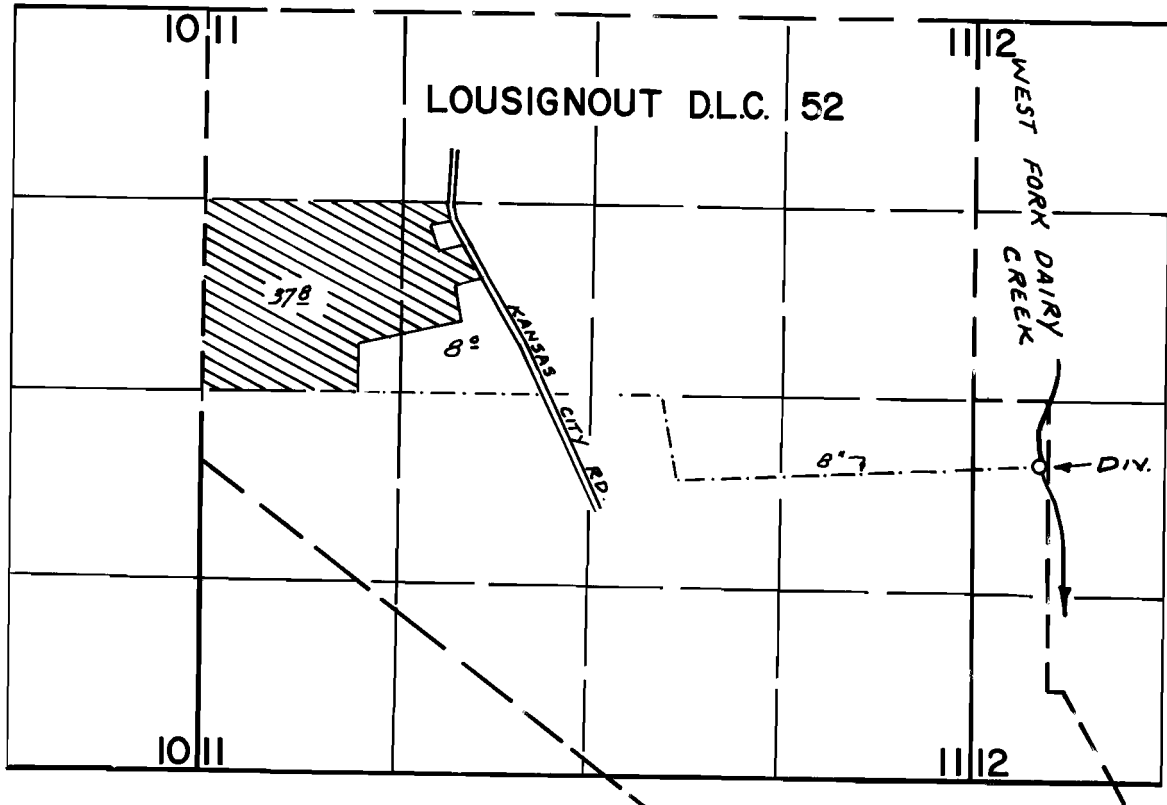

DIV. PT. LOC: 3070'S. & 450'E. FROM N.W. COR. SEC. 12

FINAL PROOF SURVEY UNDER

Application No. ~~55799~~... Permit No. ~~41777~~.....
IN NAME OF

.....EUGENE M. VANDEHEY.....

Surveyed MAY 2, 1979., by R. G. MUCKEN