


# T.2S.R.3W.W.M.

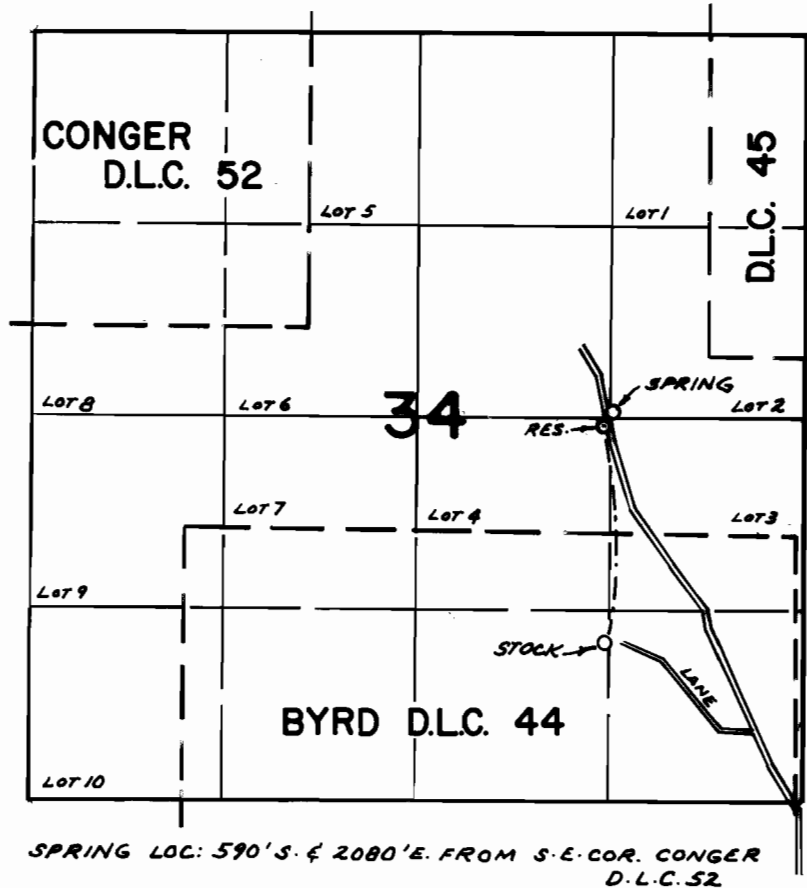

## FINAL PROOF SURVEY UNDER

Application No. 58128... Permit No. 43769.....  
IN NAME OF

.....IVAN W. MILLER.....

Surveyed OCT. 18, 1979., by P.G. MUGKEN