


T.13&14S., R.7W., W.M.

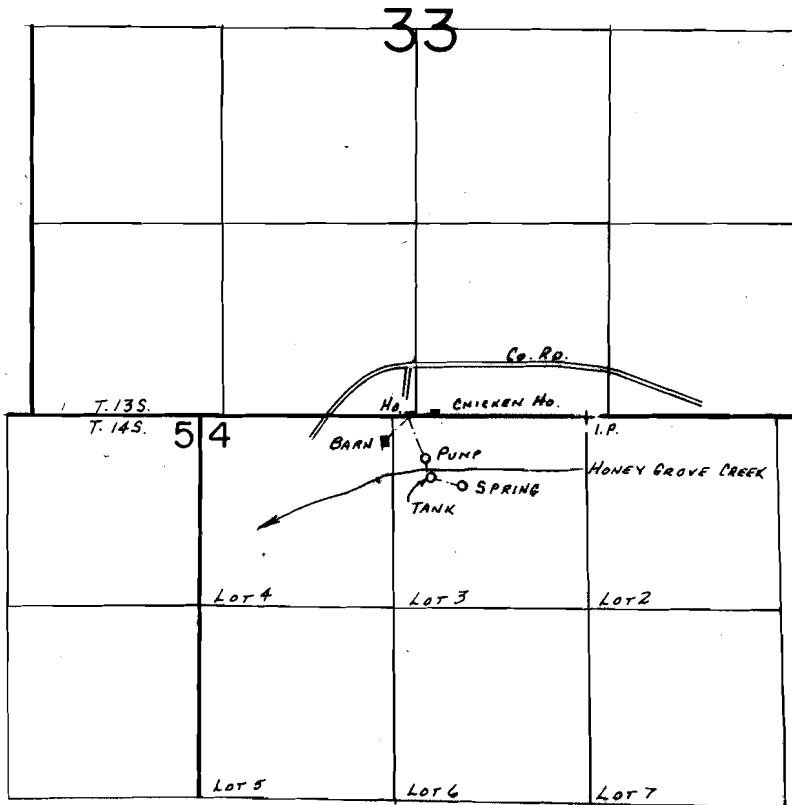

SPRING LOC.: 480'S. & 850'W. FROM N 1/4 COR. SEC. 4.

SCALE: 1" = 1320'

FINAL PROOF SURVEY UNDER

Application No. 61268.... Permit No. 45624.....
IN NAME OF

.....GARY & GISELA GREEN.....

Surveyed Aug. 1..... 1984., by L.M.TOLL.....