


T.10S., R.4W., W.M.

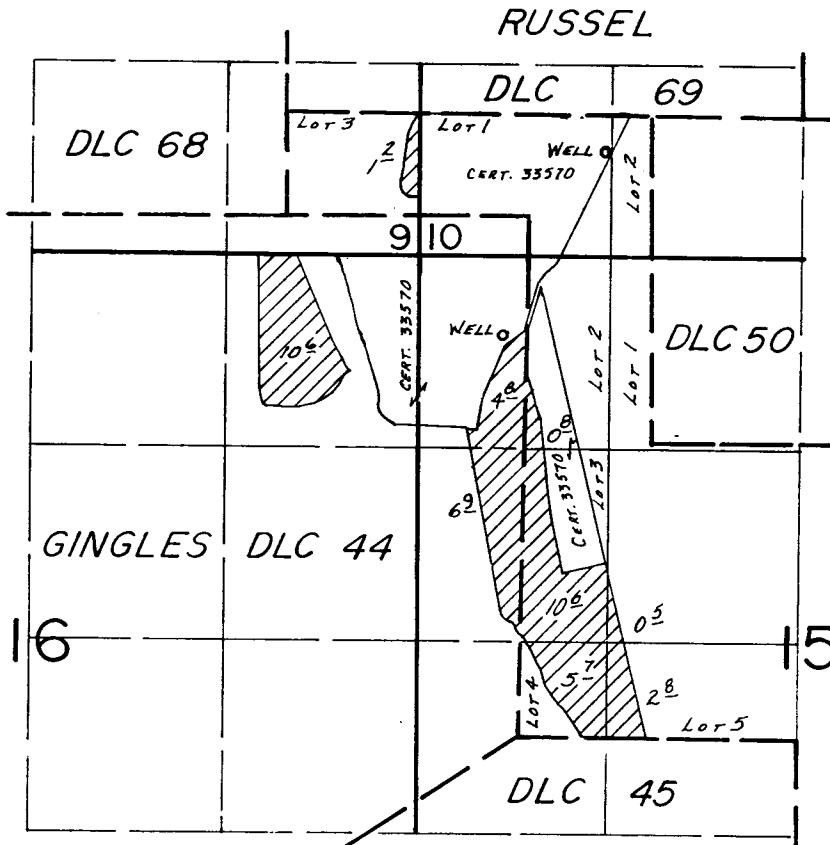

WELLS LOC.: 280'S. & 1325' W. & 1540' S. & 2040' W, BOTH FROM SE COR. RUSSEL DLC 69.

SCALE: 1" = 1320'

FINAL PROOF SURVEY UNDER

Application No. G-8068 Permit No. G-7468...
IN NAME OF

.....RUSSELL UNDERWOOD.....

Surveyed June 29, 1984, by L.M. TOLL.....