


T.10S., R.4W., W.M.

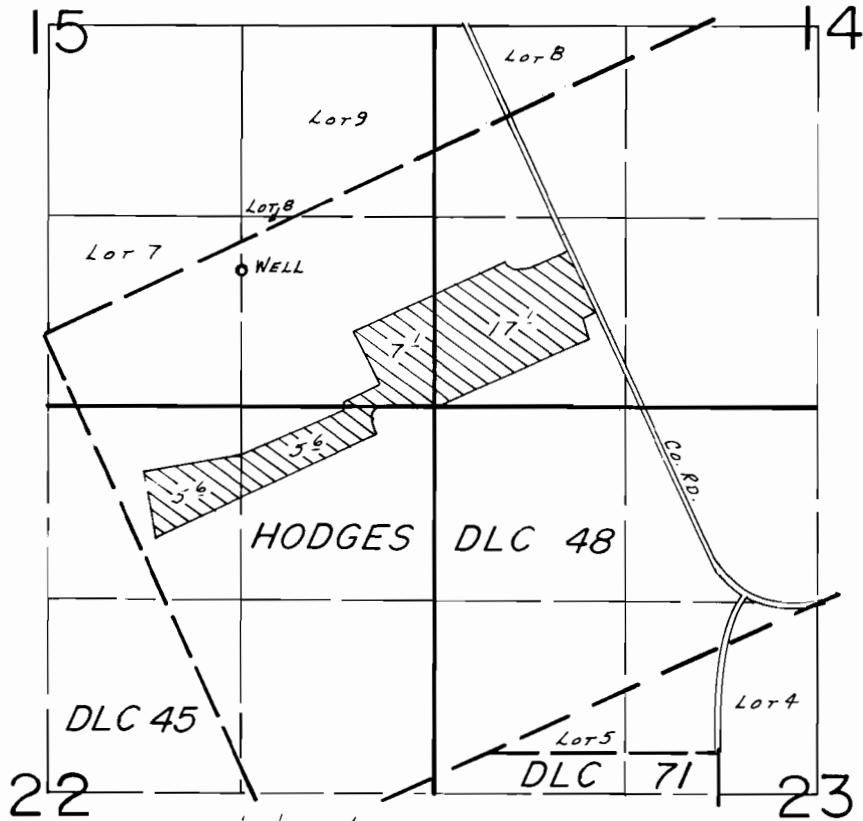

WELL LOC.: 430' N. & 1360' E. FROM NW COR. HODGES DLC 48.

SCALE: 1" = 1320'

FINAL PROOF SURVEY
UNDER

Application No. G-7990 Permit No. G-7575.....
IN NAME OF

.....RUSSELL UNDERWOOD.....

Surveyed June 29, 1984, by L.M.TOLL.....