


T. 5N., R. 6W., W.M.  
SECTION 4

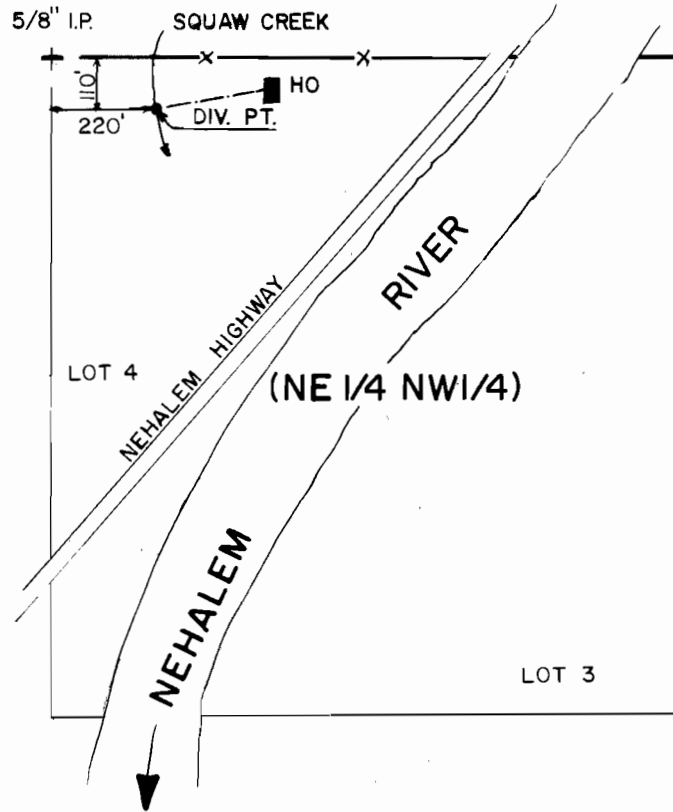

SCALE: 1" = 400'

**FINAL PROOF SURVEY**  
UNDER

Application No. 66277... Permit No. 47736.....

IN NAME OF

**JAMES M. & VERA L. CRISP**

Surveyed JULY 23, 1985, by B.W. BISHOP.....