


P-43092
53849

T. 9S. R. 27E. W. M.

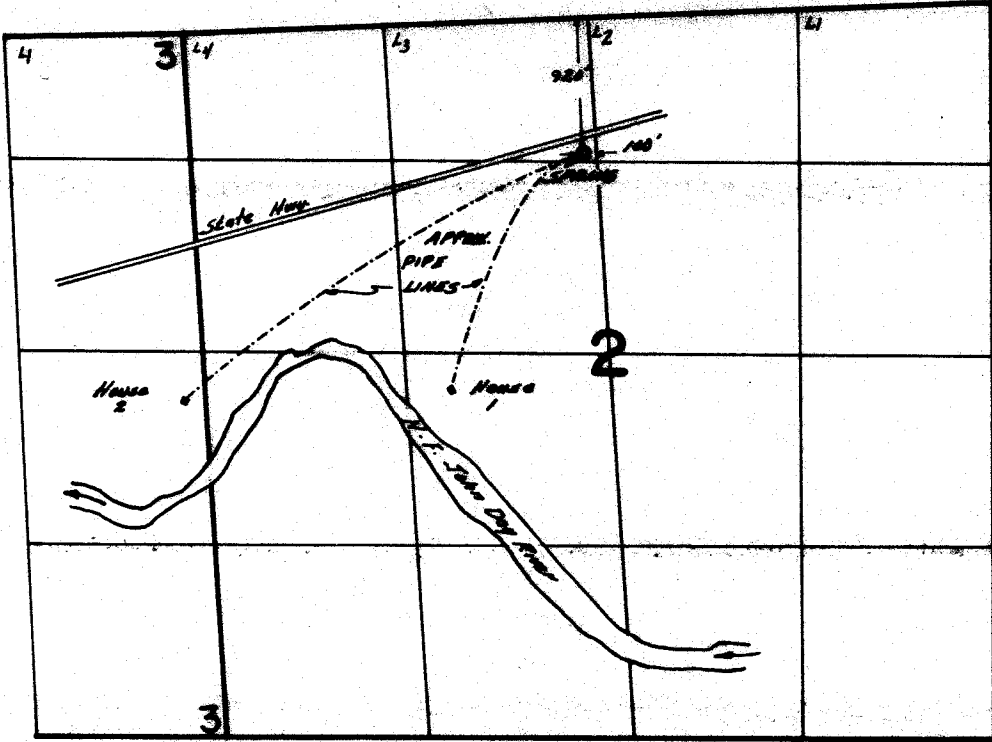

FINAL PROOF SURVEY UNDER

Application No. 57296. Permit No. 43092.....
IN NAME OF

.....LARRY G. & NANCY A. WIRES.....

Surveyed July 12, 1979, by S.C. BROWN.....