


C-53850
P-44152

T9S. R27E. WM.

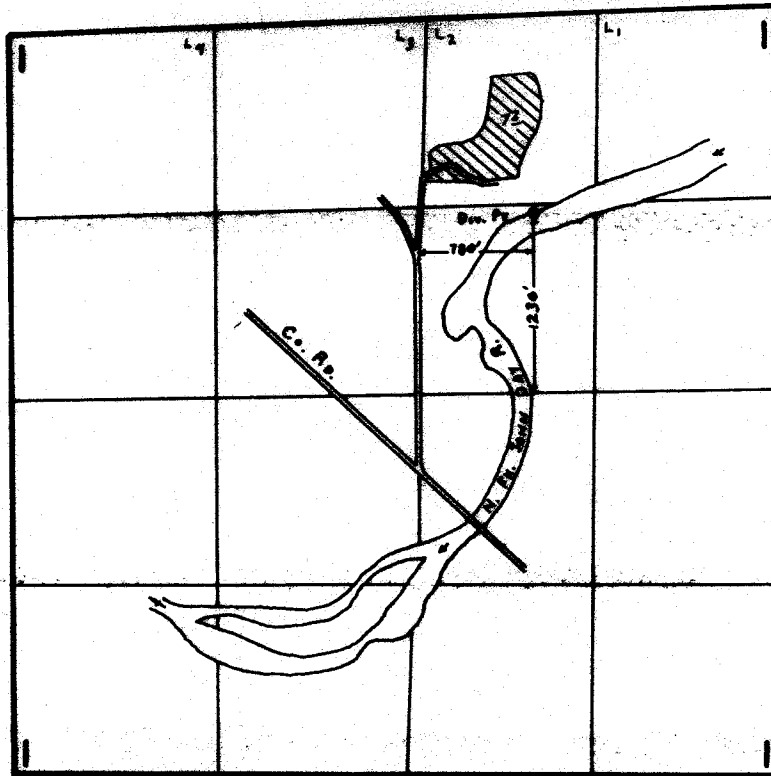

FINAL PROOF SURVEY UNDER

Application No. 58572.. Permit No. 44152....
IN NAME OF

JAMES M. STUBBLEFIELD.....

Surveyed July 12.. 1979.. by S. C. BROWN....