



# T.28S.,R.14E.,W.M.

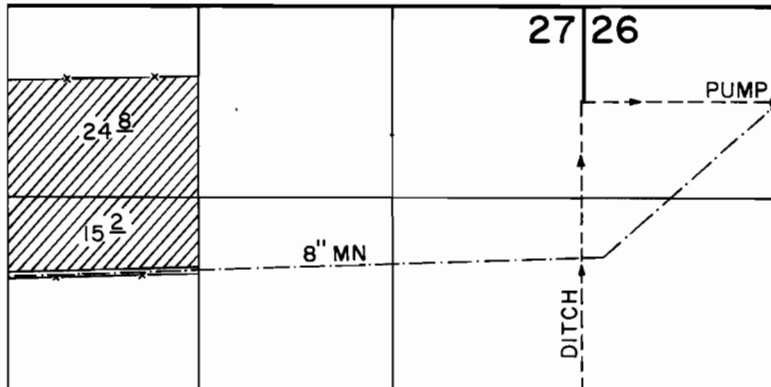

SCALE: 1" = 1320'

# T.30S.,R.14E.,W.M.

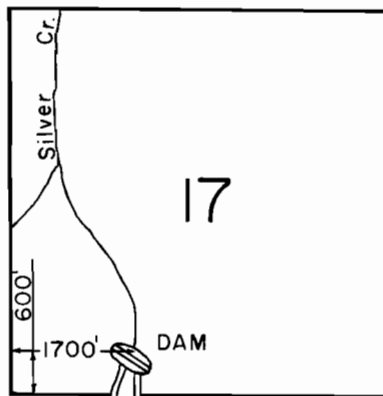

SCALE: 1" = 2640'

## FINAL PROOF SURVEY UNDER

Application No. 61173... Permit No. 46368....  
IN NAME OF

SILVER LAKE IRRIGATION DISTRICT - ZX RANCH

Surveyed SEPT. 14 1985., by J. WARREN.....