


T.26S., R.15E., W.M.

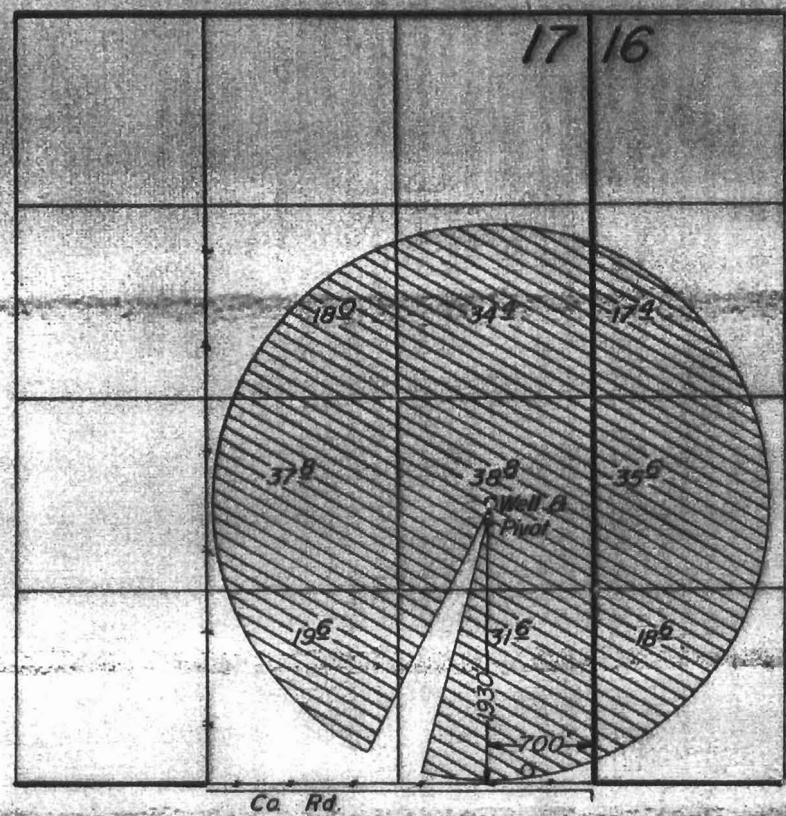

Scale : 1" = 1320'

FINAL PROOF SURVEY UNDER

Application No. G-8850. Permit No. G-8251.....
IN NAME OF

ROBERT R. TUTTLE

Surveyed Oct. 11, 1985, by T. Warren