


T. 25S., R. 19E., W.M.

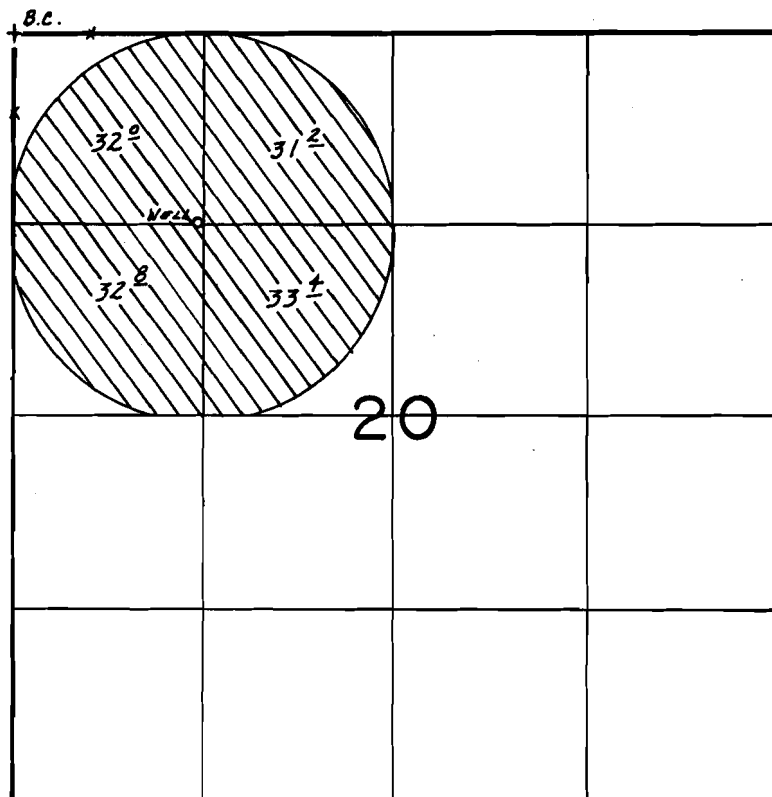

WELL LOC.: 1300 S. & 1290 E. FROM NW COR. SEC. 20.

SCALE: 1"=1320'

FINAL PROOF SURVEY

UNDER

Application No. G-10327 Permit No. G-9355....
IN NAME OF

CHARLES A. & JUDITH S. HUSS....

Surveyed Sept. 18... 1985, by B.W. BISHOP.....