


T.26 S., R.15 E., W.M.

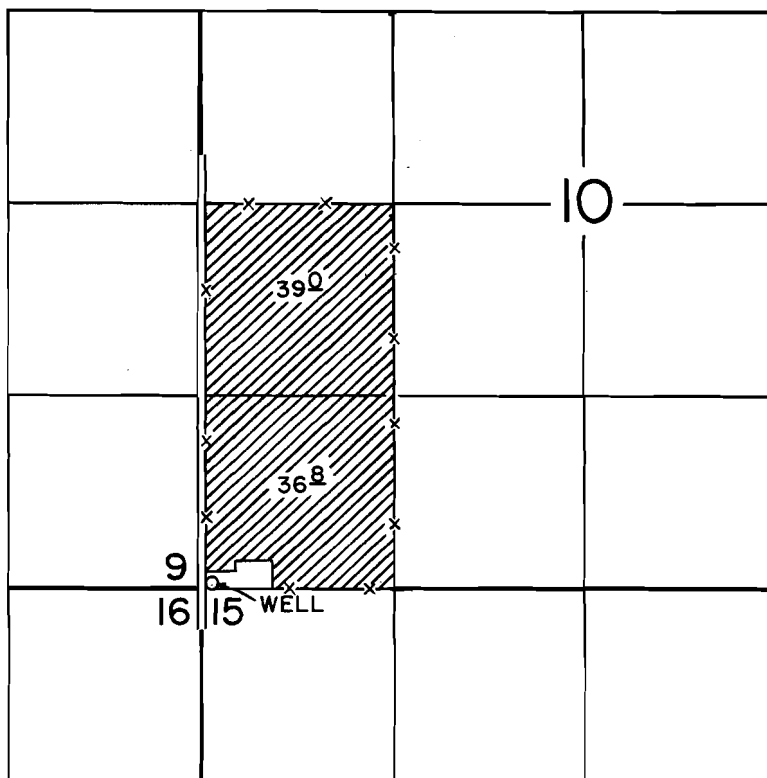

WELL LOC.: 40' N. & 50' E. FROM THE S.W. CORNER SEC. 10

SCALE: 1" = 1320'

FINAL PROOF SURVEY
UNDER

Application No. G-10377 Permit No. G-9466....
IN NAME OF

LOMA VISTA FARMS, INC.....

Surveyed SEPT. 11, 1985, by J. WARREN.....