


G-9469

53859

T. 27S., R. 16E., W.M.

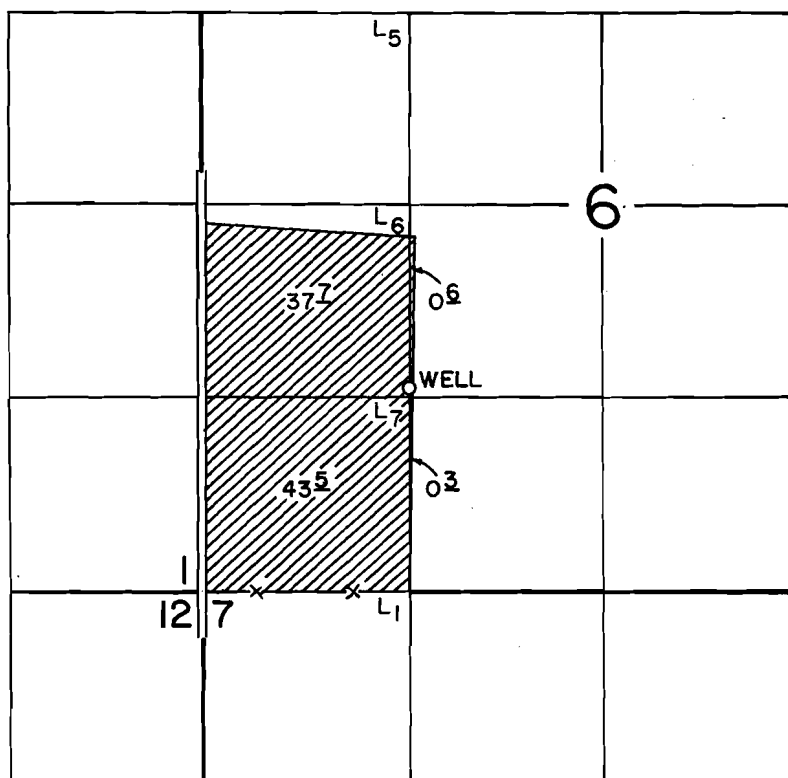

WELL LOC.: 1380' N. & 1430' E. FROM THE S.W. CORNER SEC. 6

SCALE: 1" = 1320'

FINAL PROOF SURVEY UNDER

Application No. G-10395 Permit No. G-9469....
IN NAME OF

.....LOMA VISTA FARMS, INC.

Surveyed SEPT. 11, 1985, by J. WARREN.....