

KNOX SPRING


2
2
2
2

CROOK CO.

5366
3252

PRICE OF STATE - 10.00

JUN

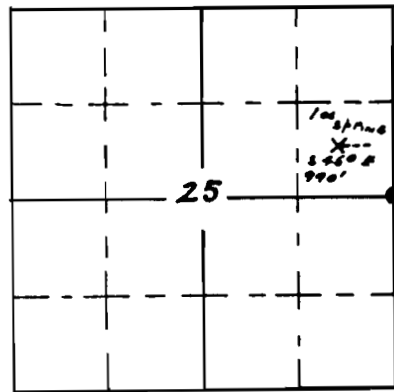

T 16 S. R 18 E W 11

p
p
p
p